


Sketch of Midship section of the Brigantine Cecilia, No. 411 in the Reg. Book.
 Scale half an inch to the foot.

Report No. 171. *Largest of class!*

14/8/76

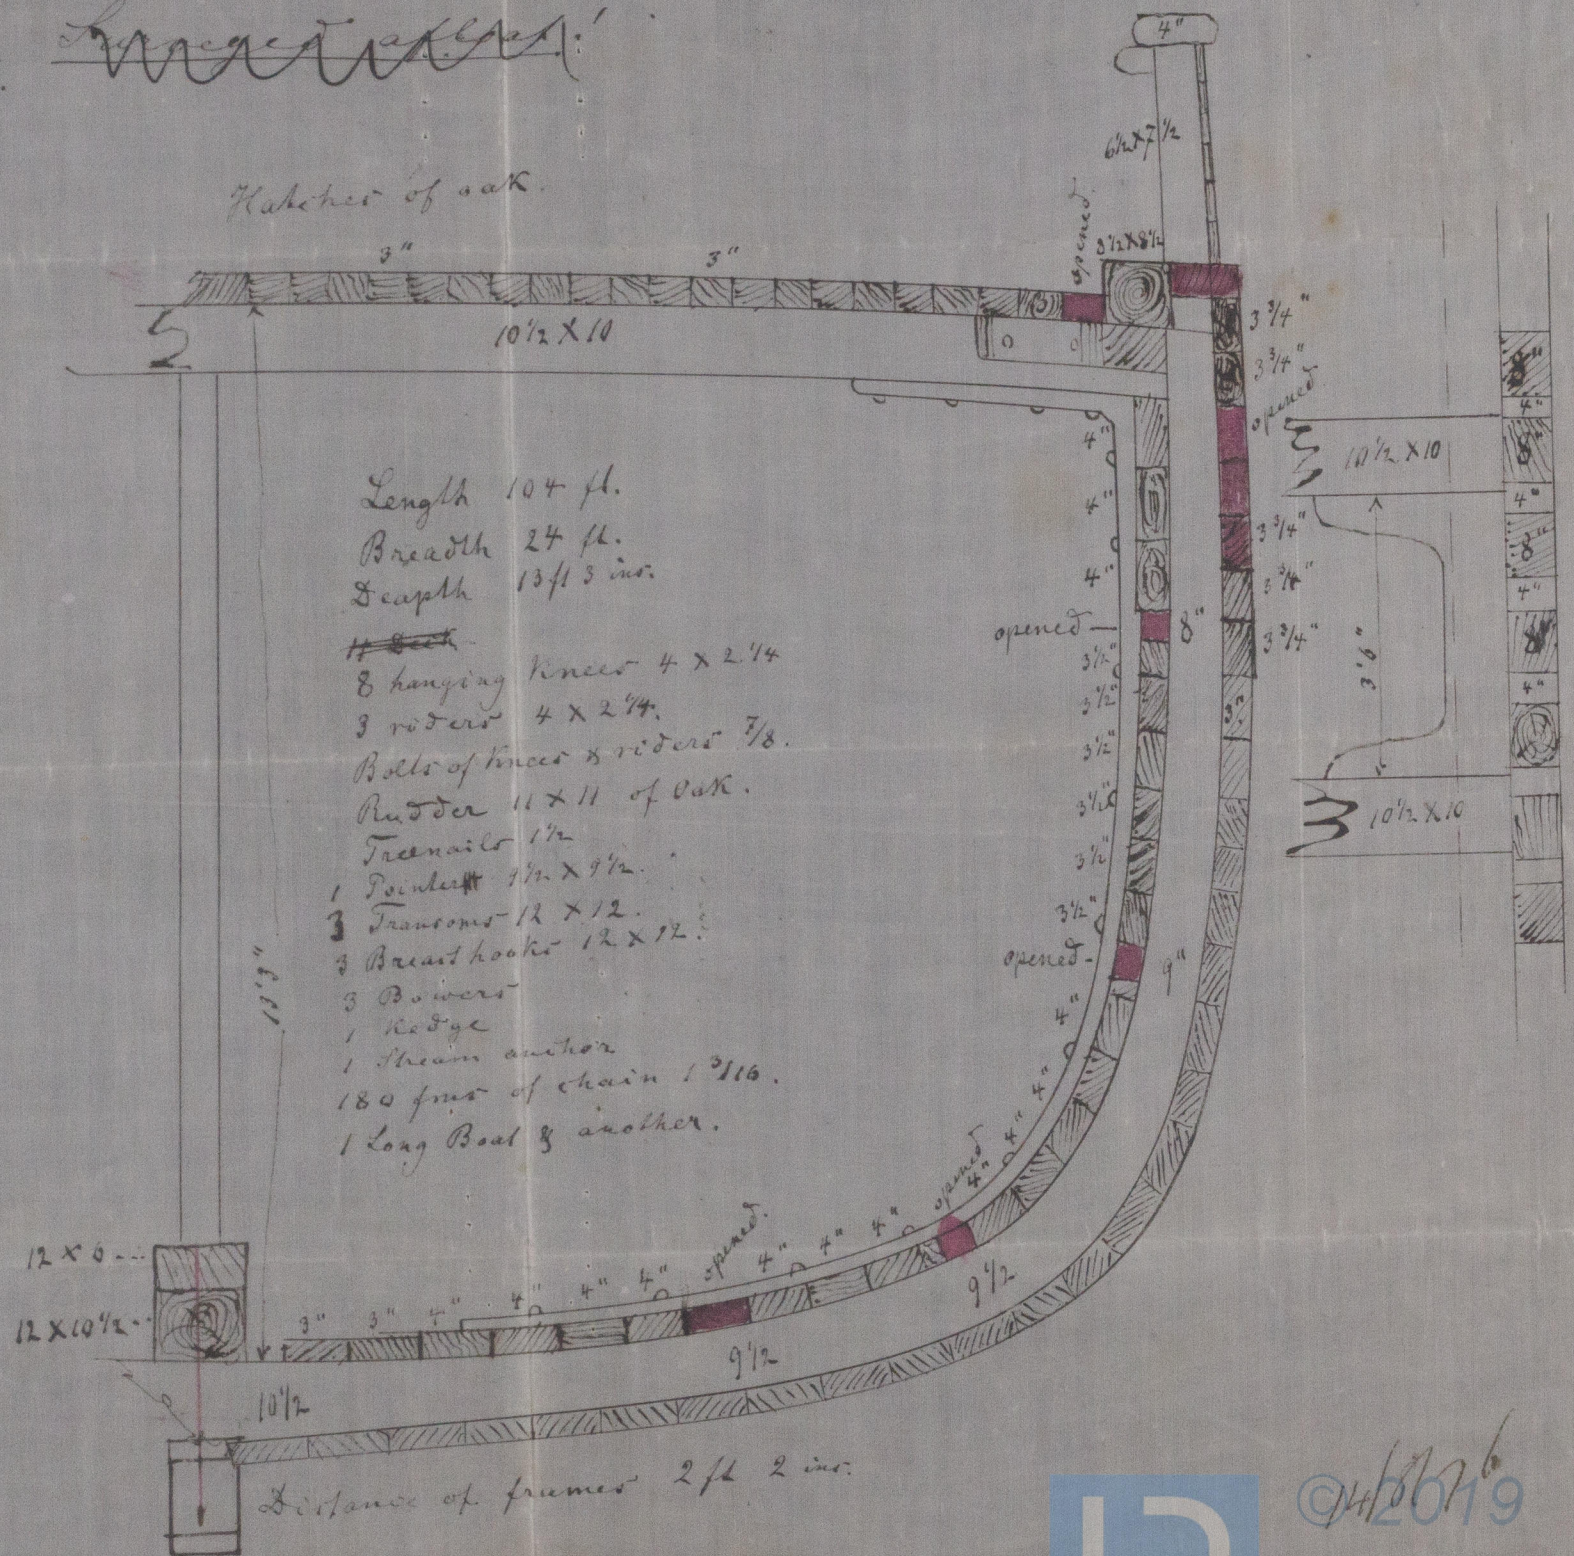

© 14/8/76

Lloyd's Register
 Foundation