


24/11/81

Defiance

Defiance

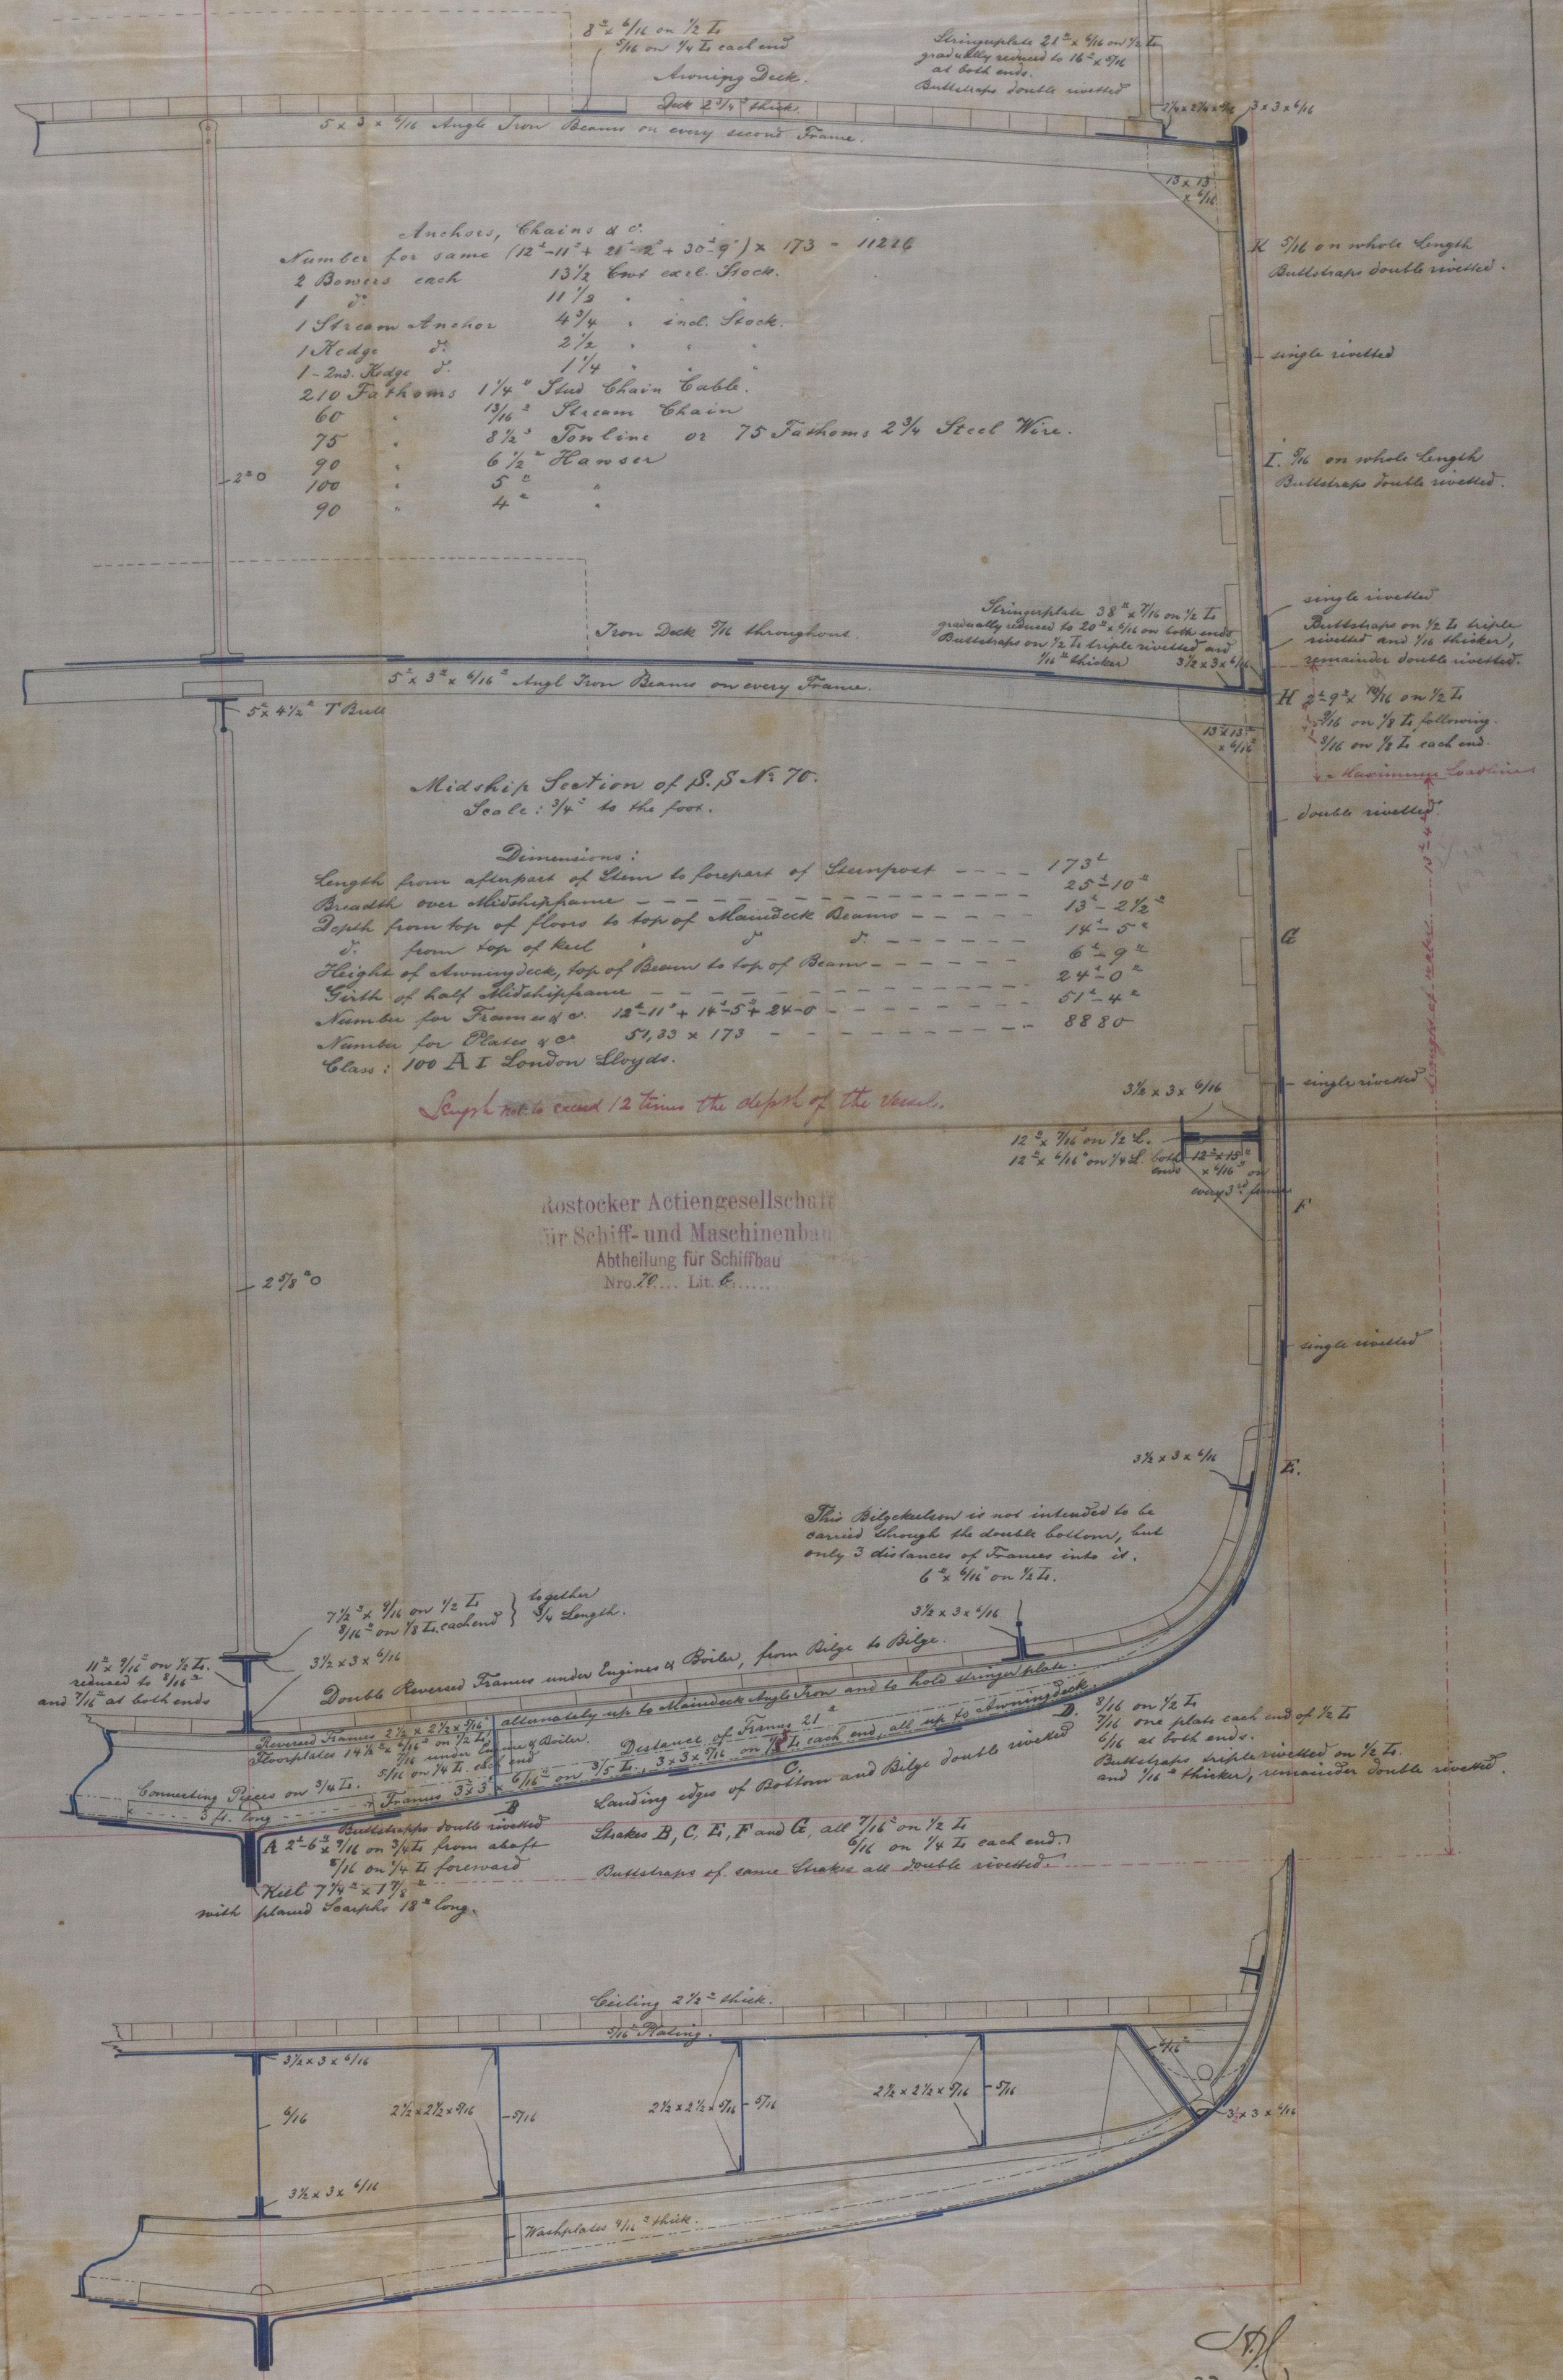

Anchors, Chains & c.
 Number for same (12'-11" + 21'-2" + 30'-9") x 173 = 11226
 1 Kedge 2 1/2
 1-2nd Kedge 1 1/4
 210 Fathoms 1 1/4" Stud Chain Cable.
 60 13/16" Steam Chain
 75 8 1/2" Ton line or 75 Fathoms 2 3/4 Steel Wire.
 90 6 1/2" Hanser
 100 5"
 90 4"

Midship Section of S.S. No. 70.

Dimensions:

Length from afterpart of Stem to forepart of Sternpost	173'
Breadth over Amidships	25' 10"
Depth from top of floor to top of Maindeck Beams	13' 2 1/2"
from top of keel	14' 5"
Class	100 A.I. London Lloyd's

Rostocker Actiengesellschaft
 für Schiff- und Maschinenbau
 Abtheilung für Schiffbau
