


S.S. Nordstjernen "Hamburg"  
Report No. 519.

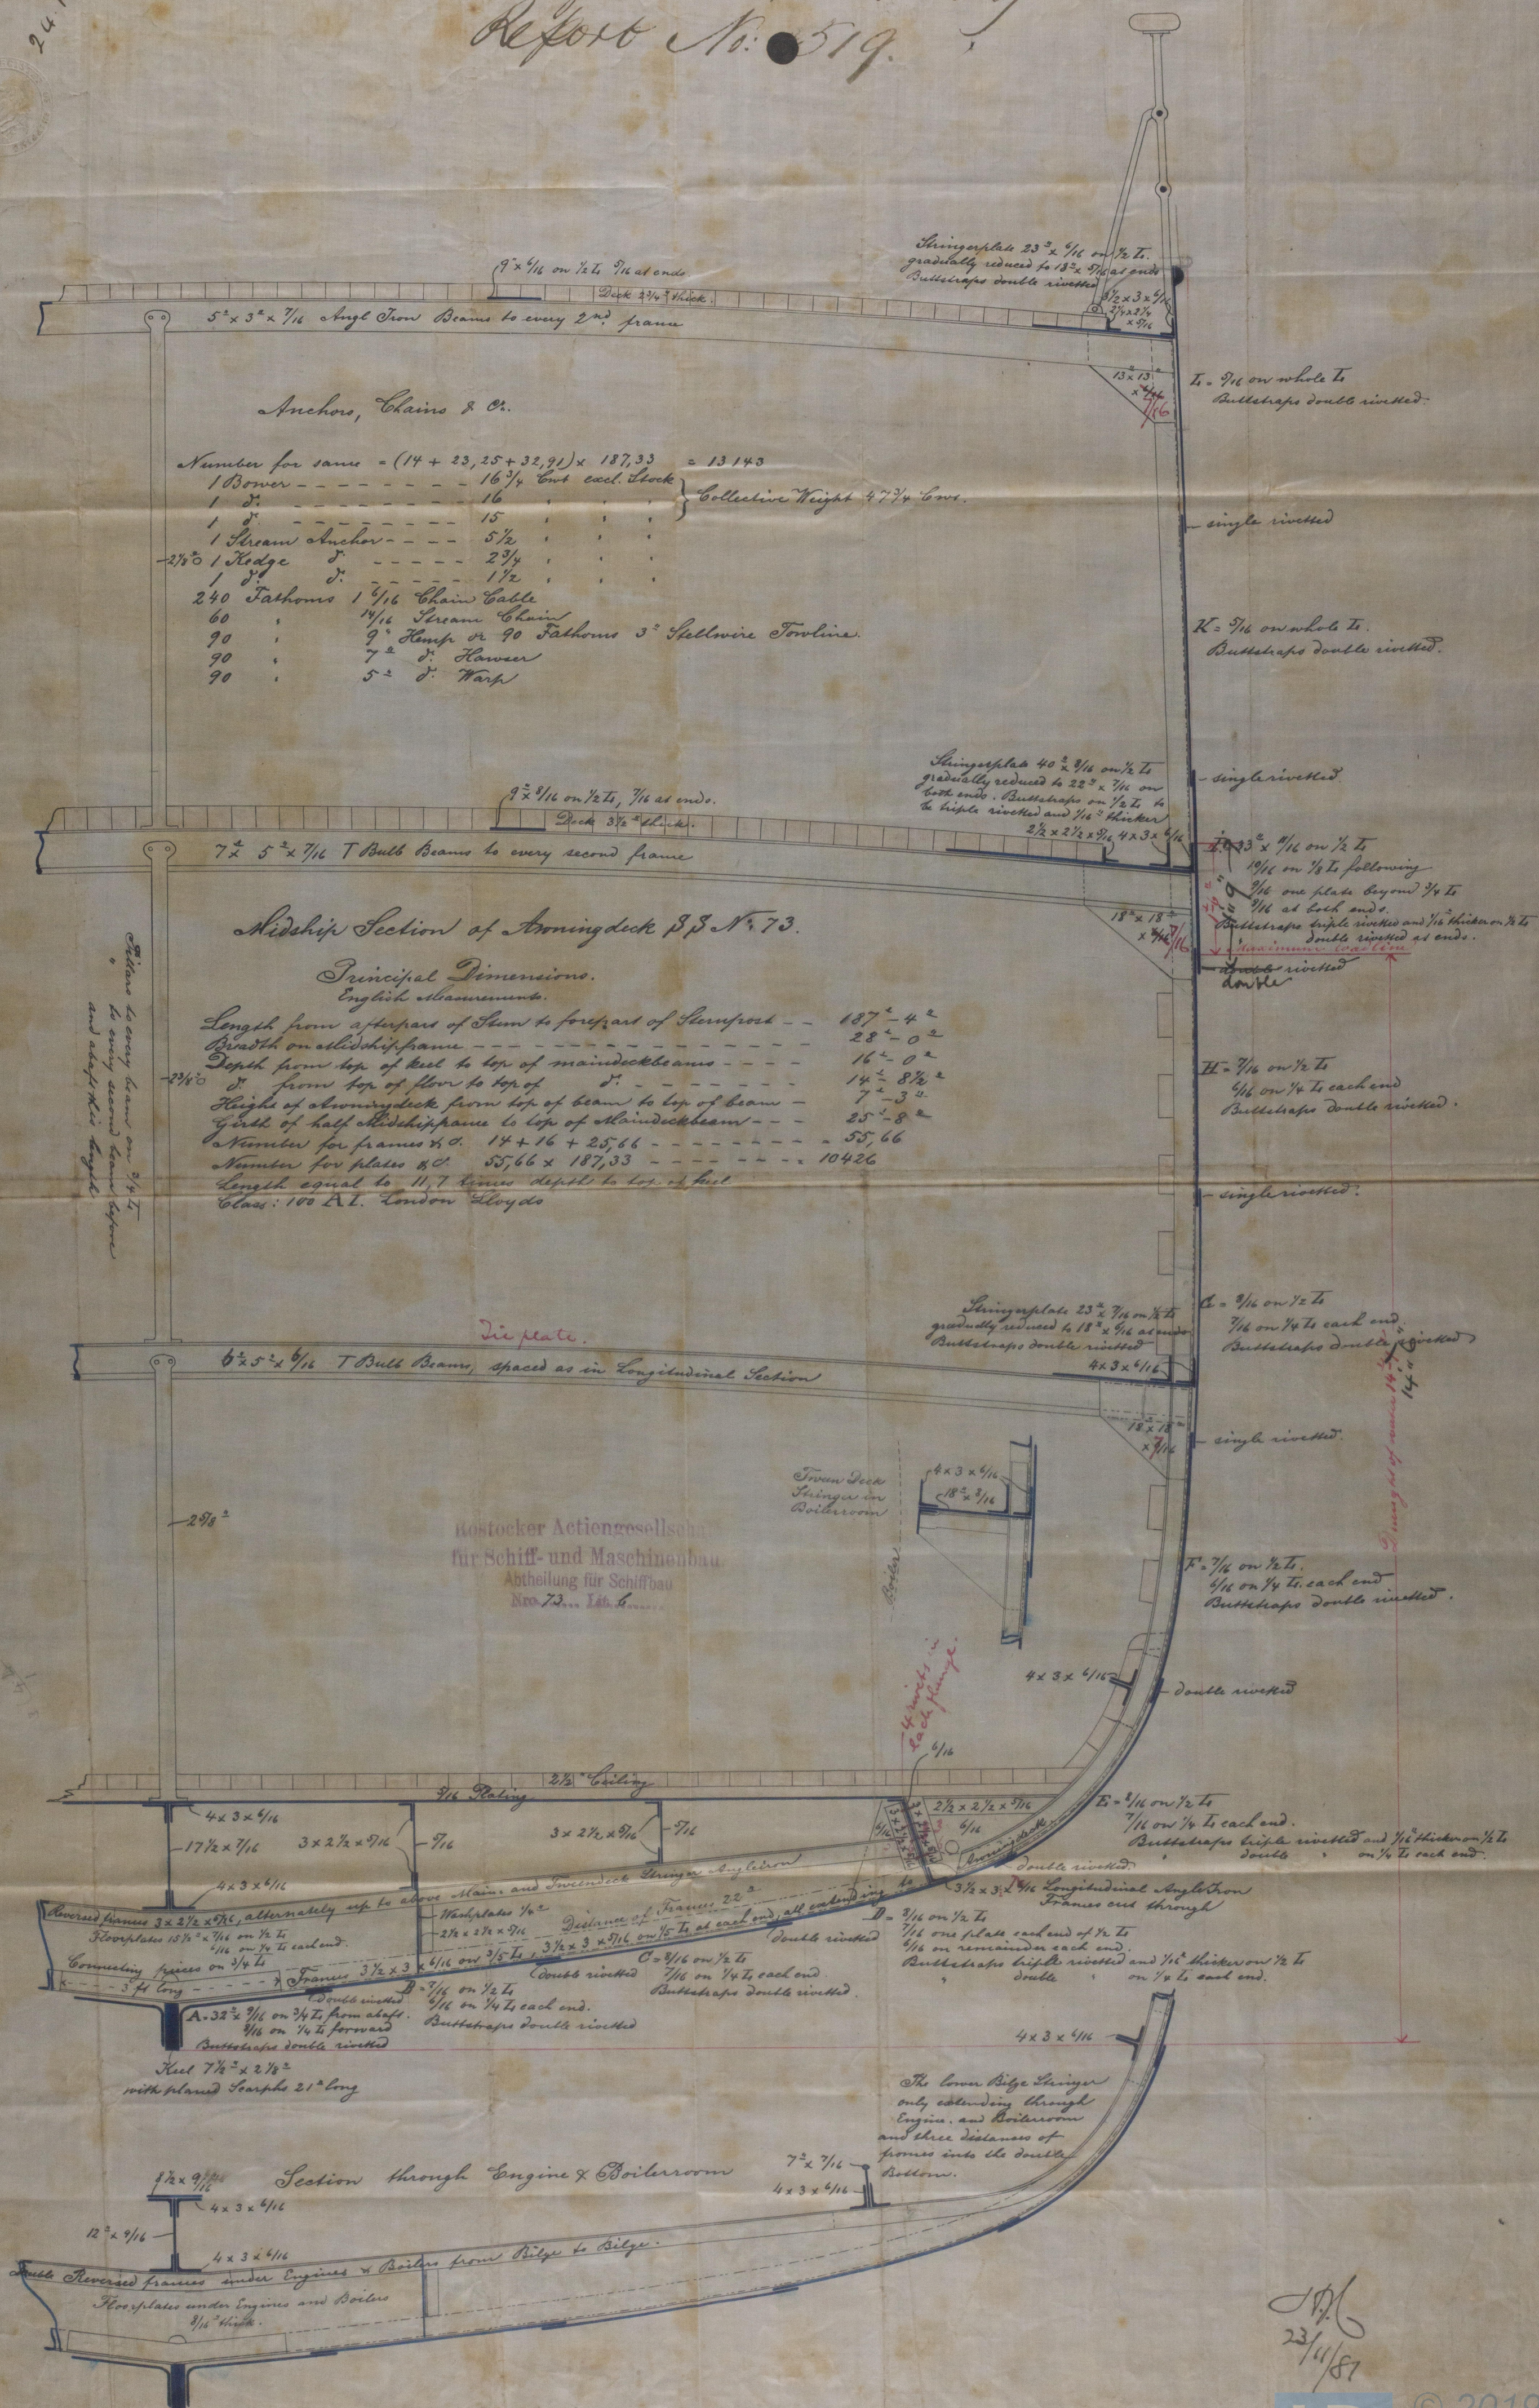

23/11/87