


Le. "Nordstjernen" Hamburg Report No. 519.



24.11.87.

Rostocker Actiengesellschaft
für Schiff- und Maschinenbau.
Abtheilung für Schiffbau
Nro. 73. Lit. A...

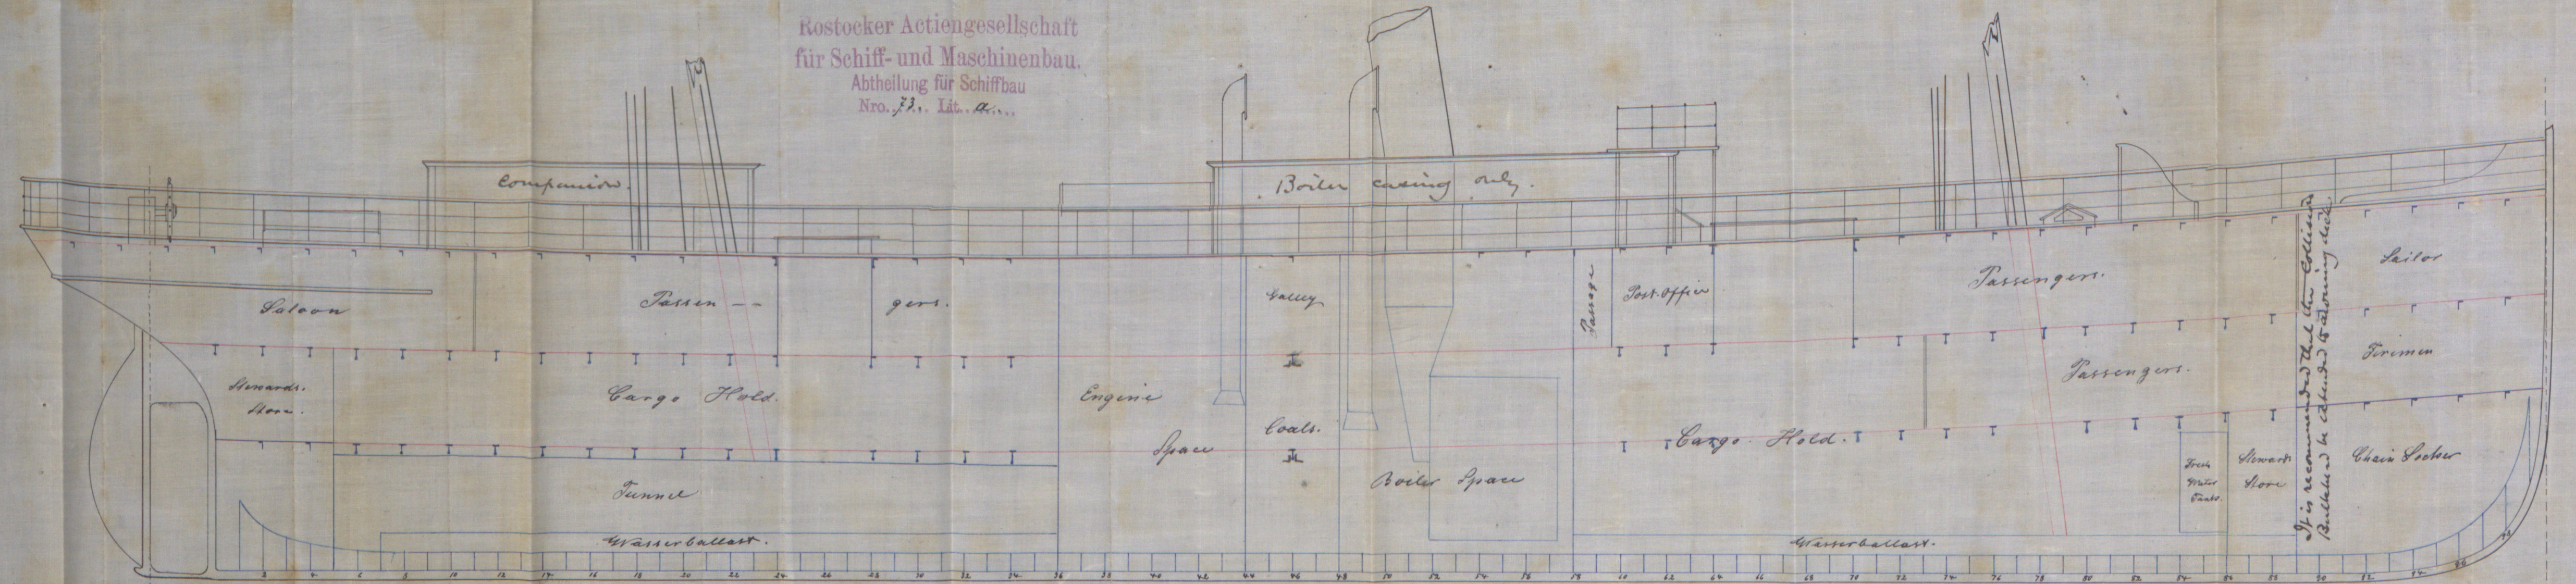

Longitudinal Section
of

Avoningsdick P.P. No. 73.
Scale 1/8" = 1' engl.

It is recommended that the following
Bulwarks be added to the following deck.

St. 16
23/11/87