


RECEIVED 17th NOV. 82.

Lt. to Ham:  
23/11/82.


S. S. "Velox"  
Report No. 588.

Double Bottom under Engine-rooms.  
1/2" 1'

Tank Girders well connected with intercostal plates.

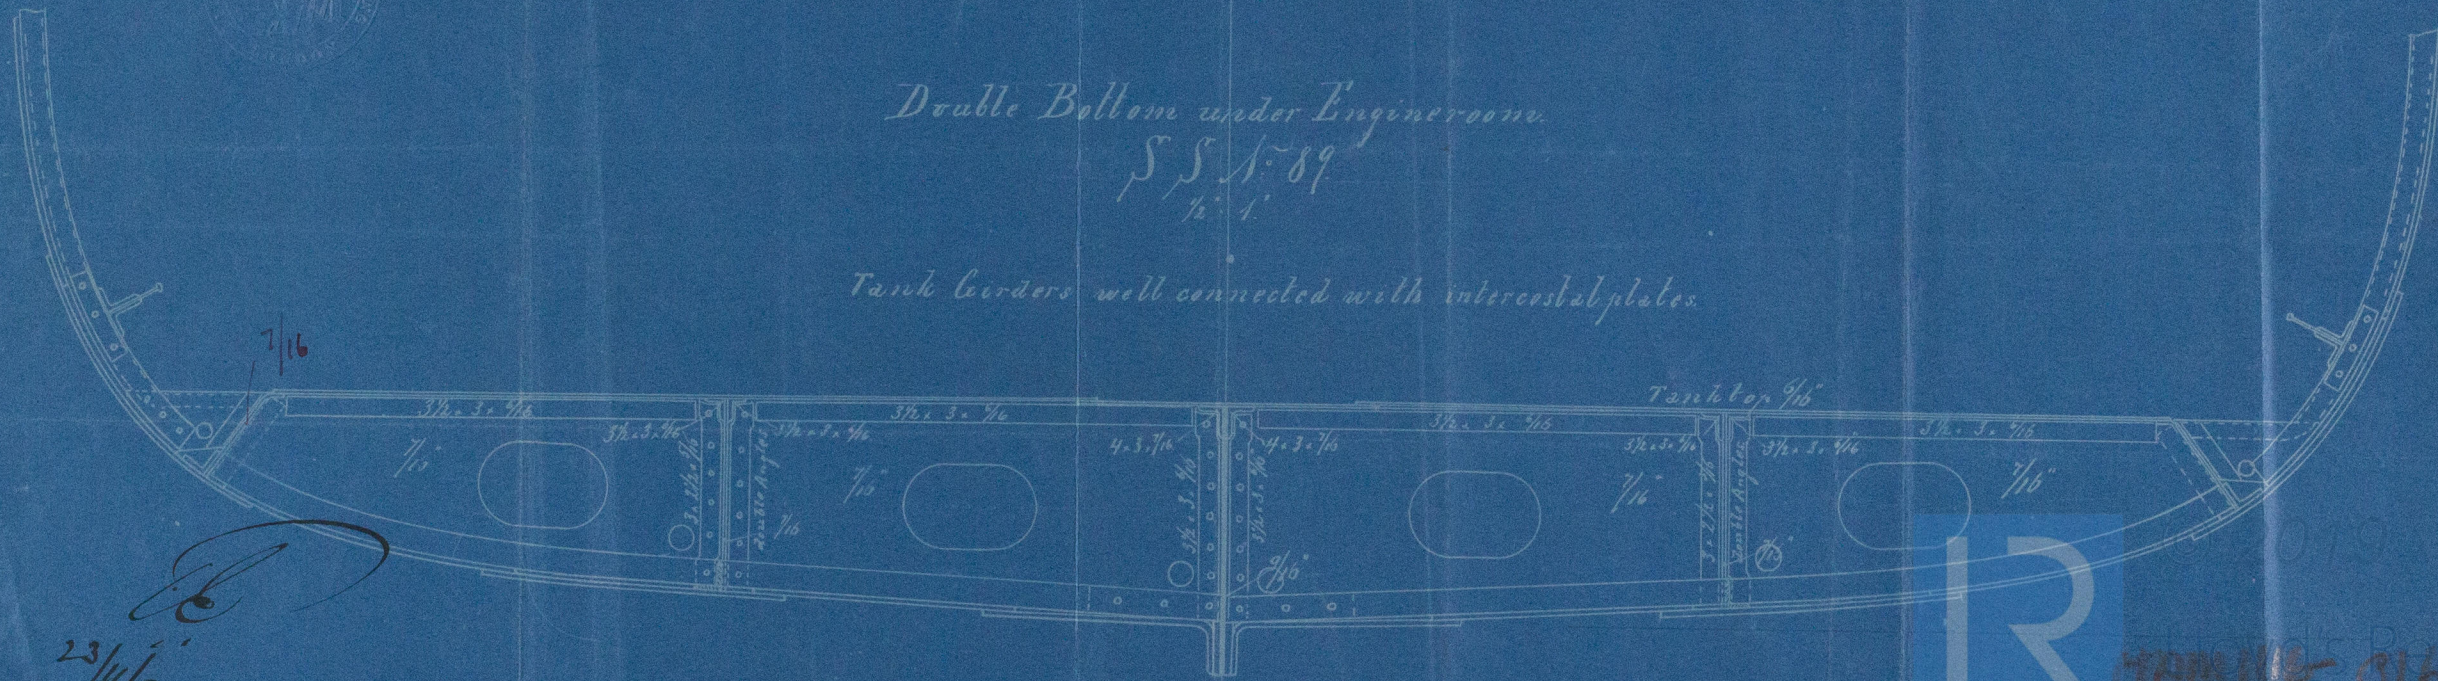

J.C.  
23/11/82

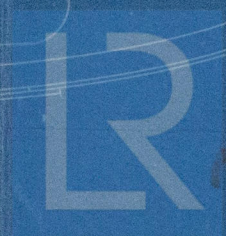

MANUSCRIPT  
FOUNDATION  
45.7-82