


RECEIVED 17th NOV. 82.

Lt. to Ham:
23/11/82.

Sketch showing arrangement of Beams & Pillars
S.S. No. 89.

S. S. Velox
Report No. 588.

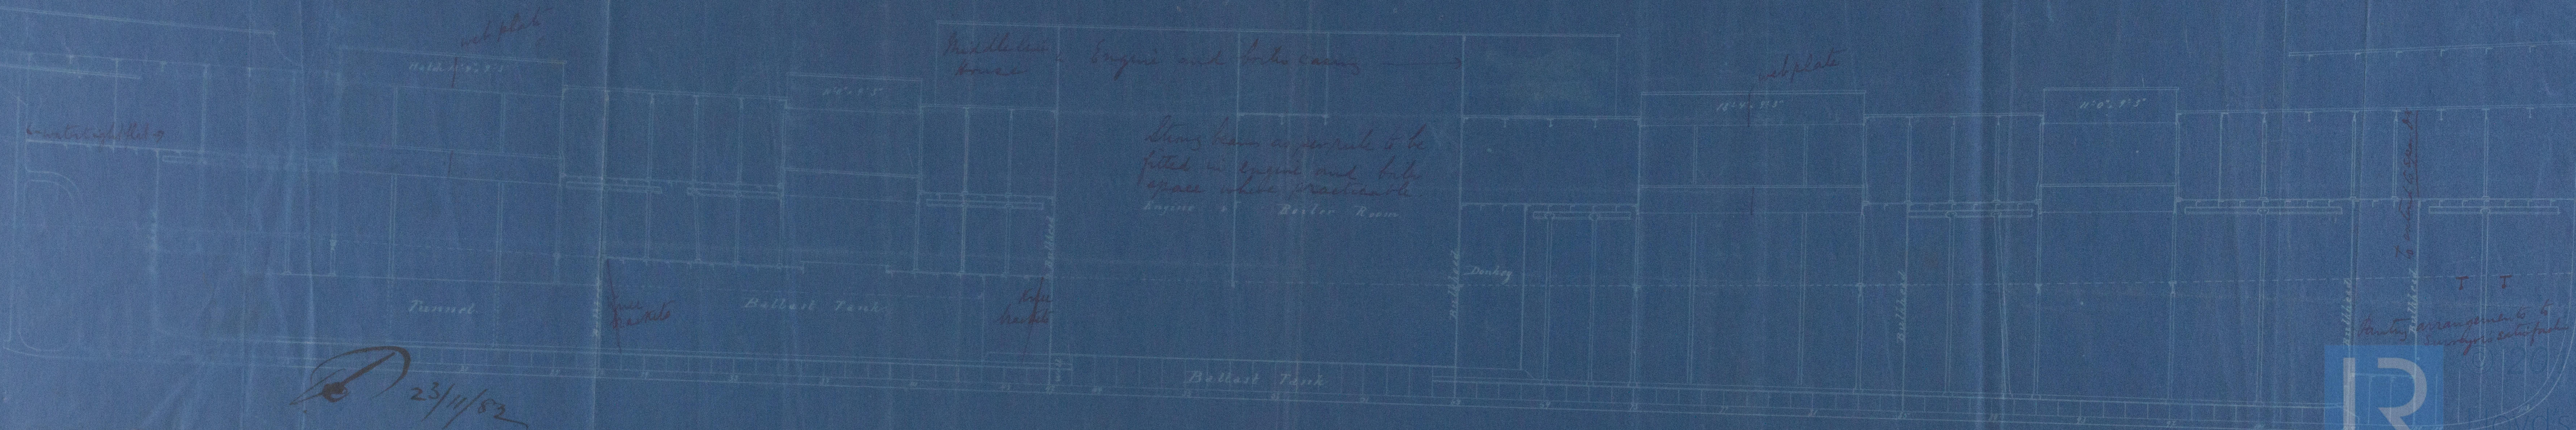

Lloyd's Register
Foundation

1828-89