


Lt. D. Ham:
23/11/82.

S. S. Velox
Report No 588.

Ballast Tank S.S. No 39.

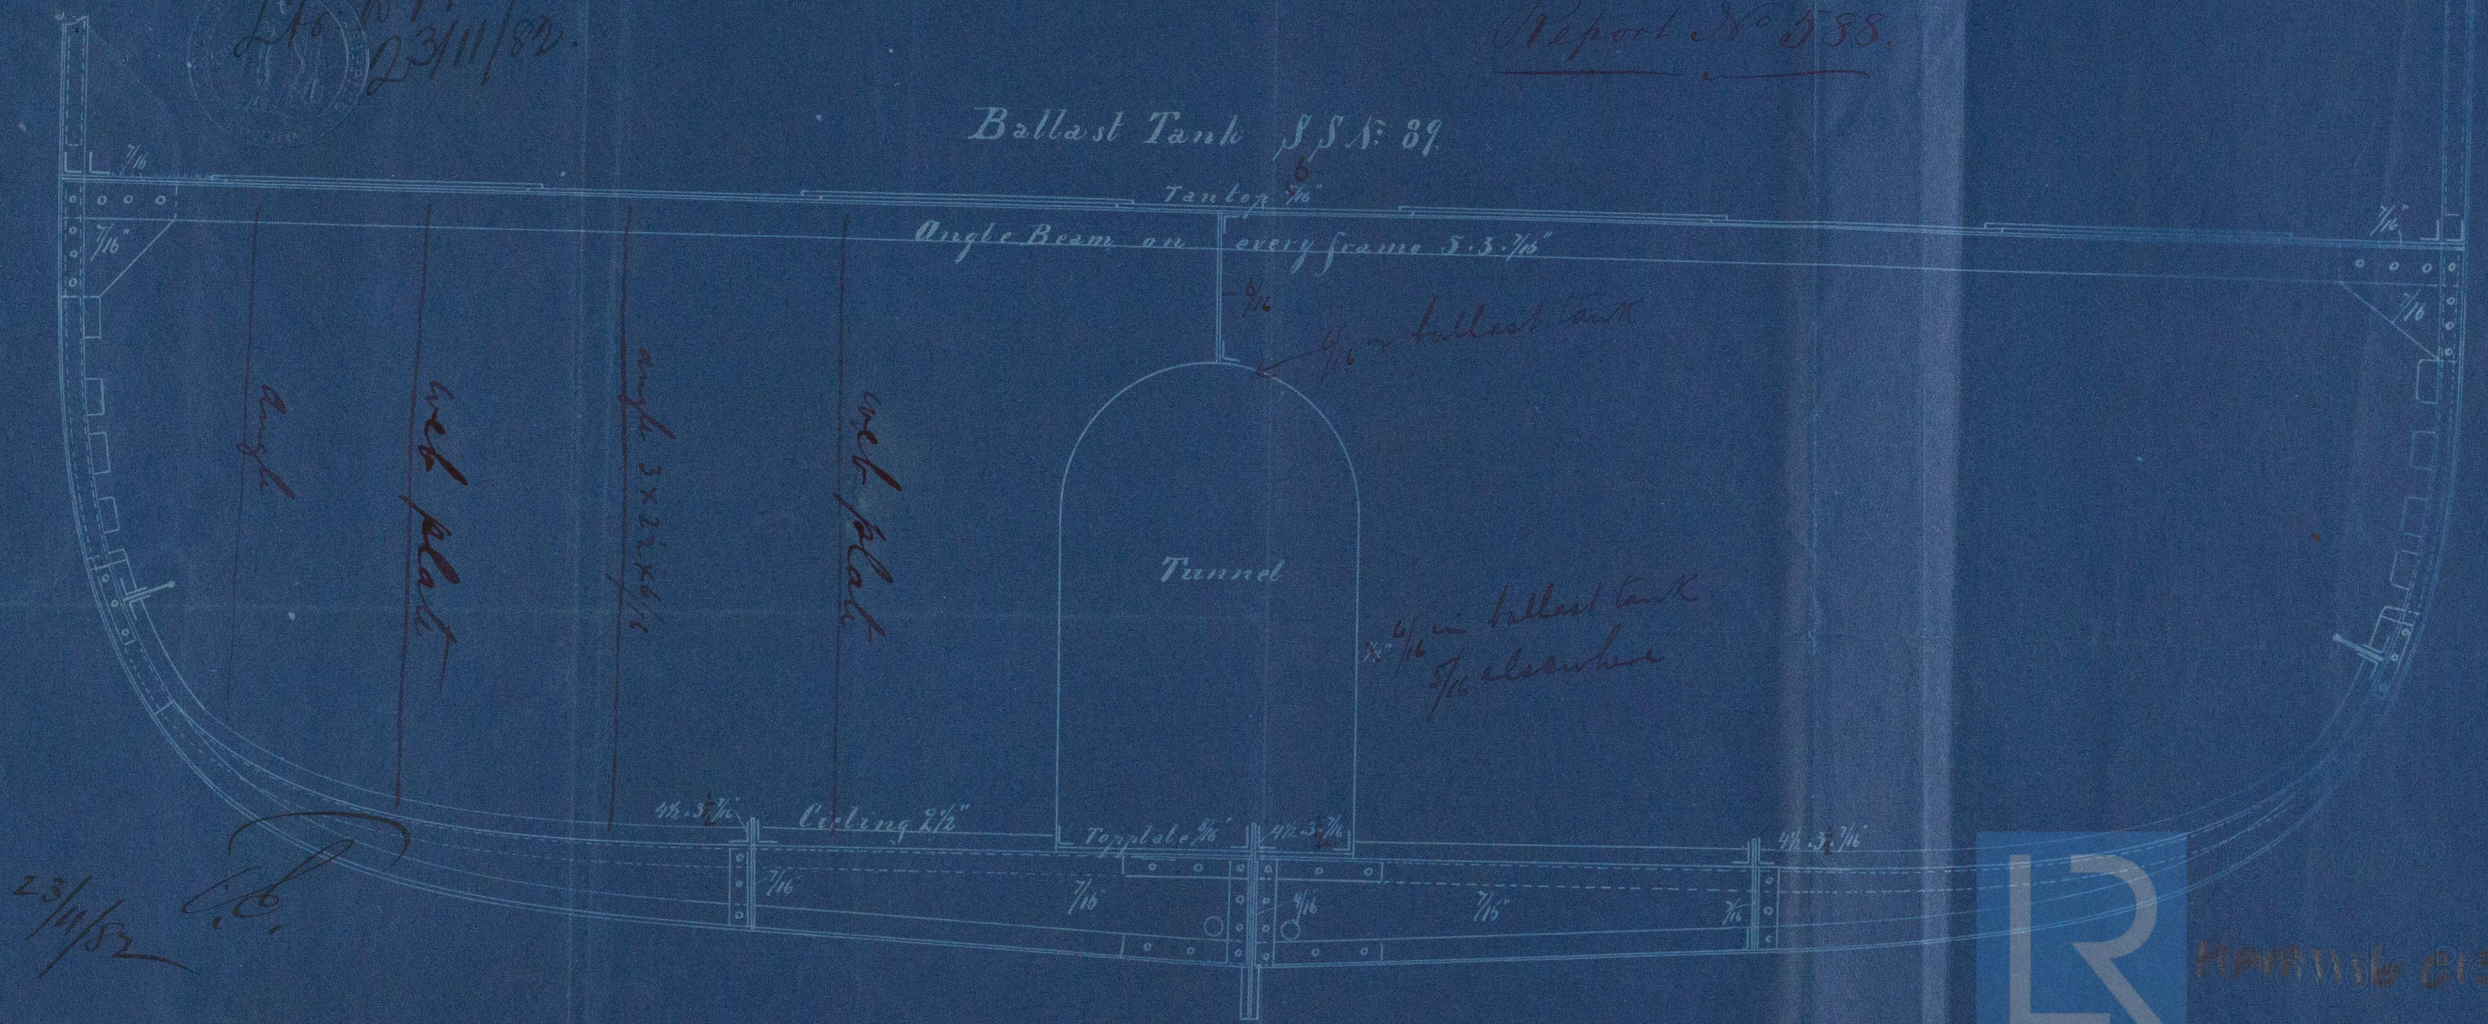

6/16 in ballast tank
5/16 elsewhere

23/11/82
C.B.



