RECEIVED 11th OCT. 82.

Emma Sauber
Hom No 615

Midshipsection of a Screw Steamer No: 344.

Hr: L Hamburg
16/10/82

Length between Perpendiculars	254 ± 0"
Breadth moulded	32, 50
Depth as pr. rule from upper part of Keel to top of upper deckbeam	22, 35

Two Decked Rule
Double Bottom Bracket System.

100 A

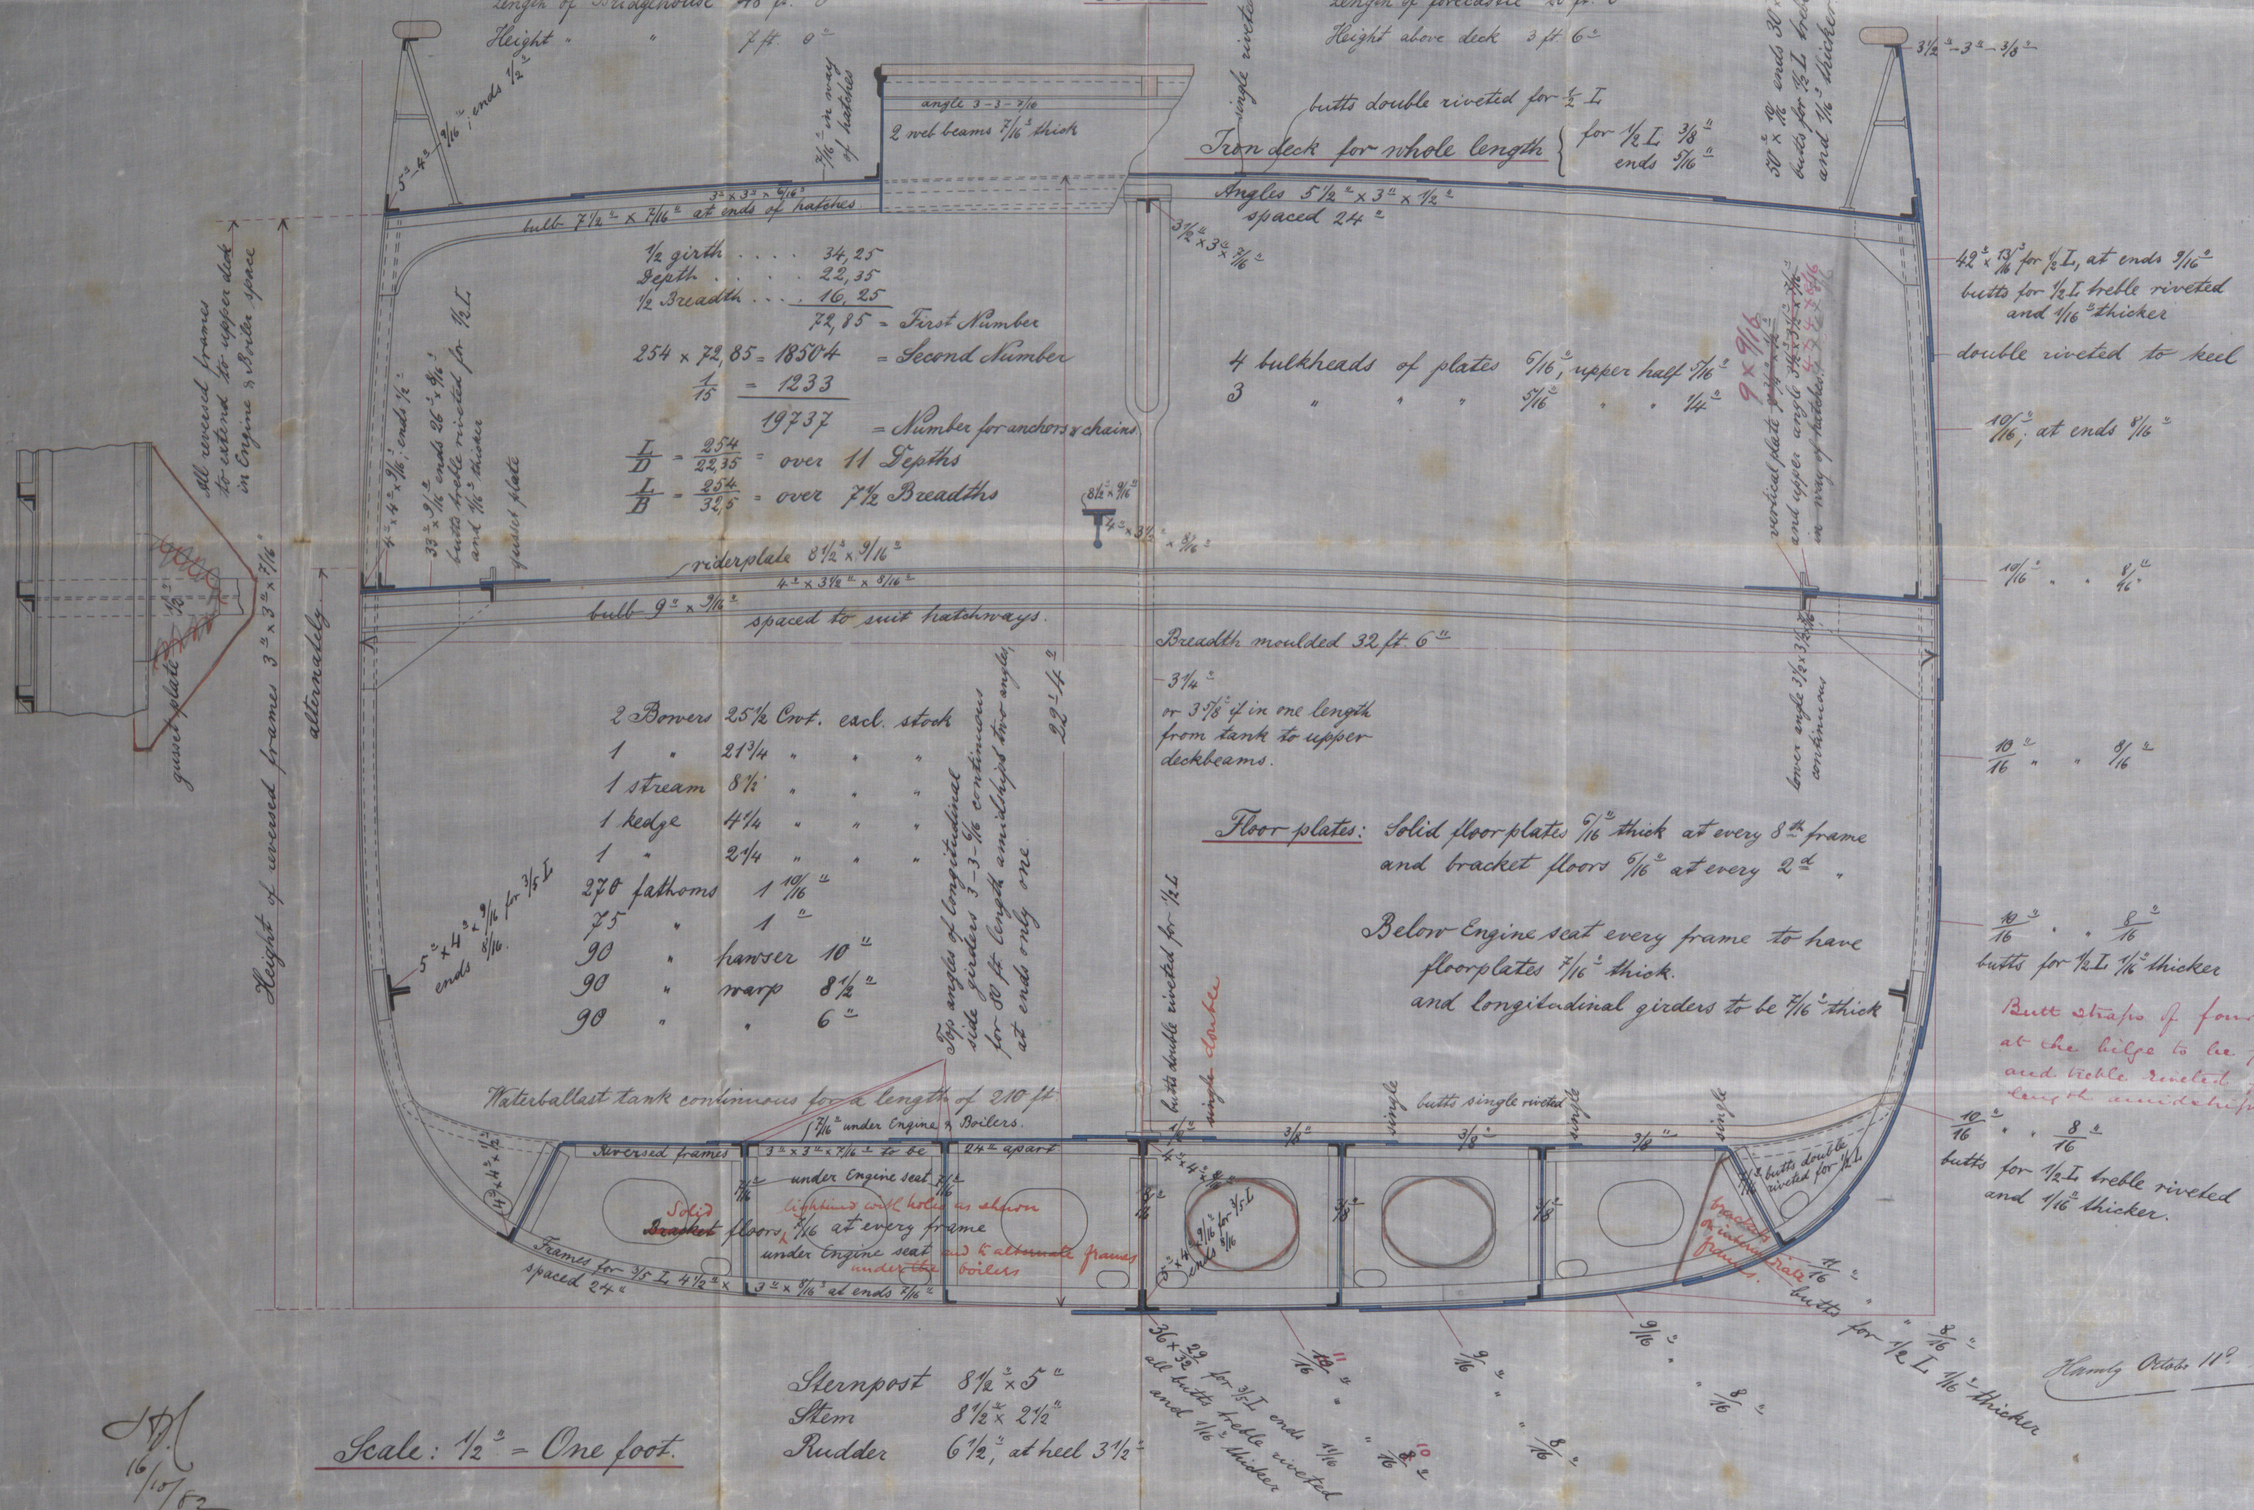

© 2019 Lloyd's Register Foundation