


*L. & H. Hamburg
16/10/82*

*S. S. Emma Huber Plan and Longitudinal Section
of a
Hull No 615
Screw Steamer No 344.*

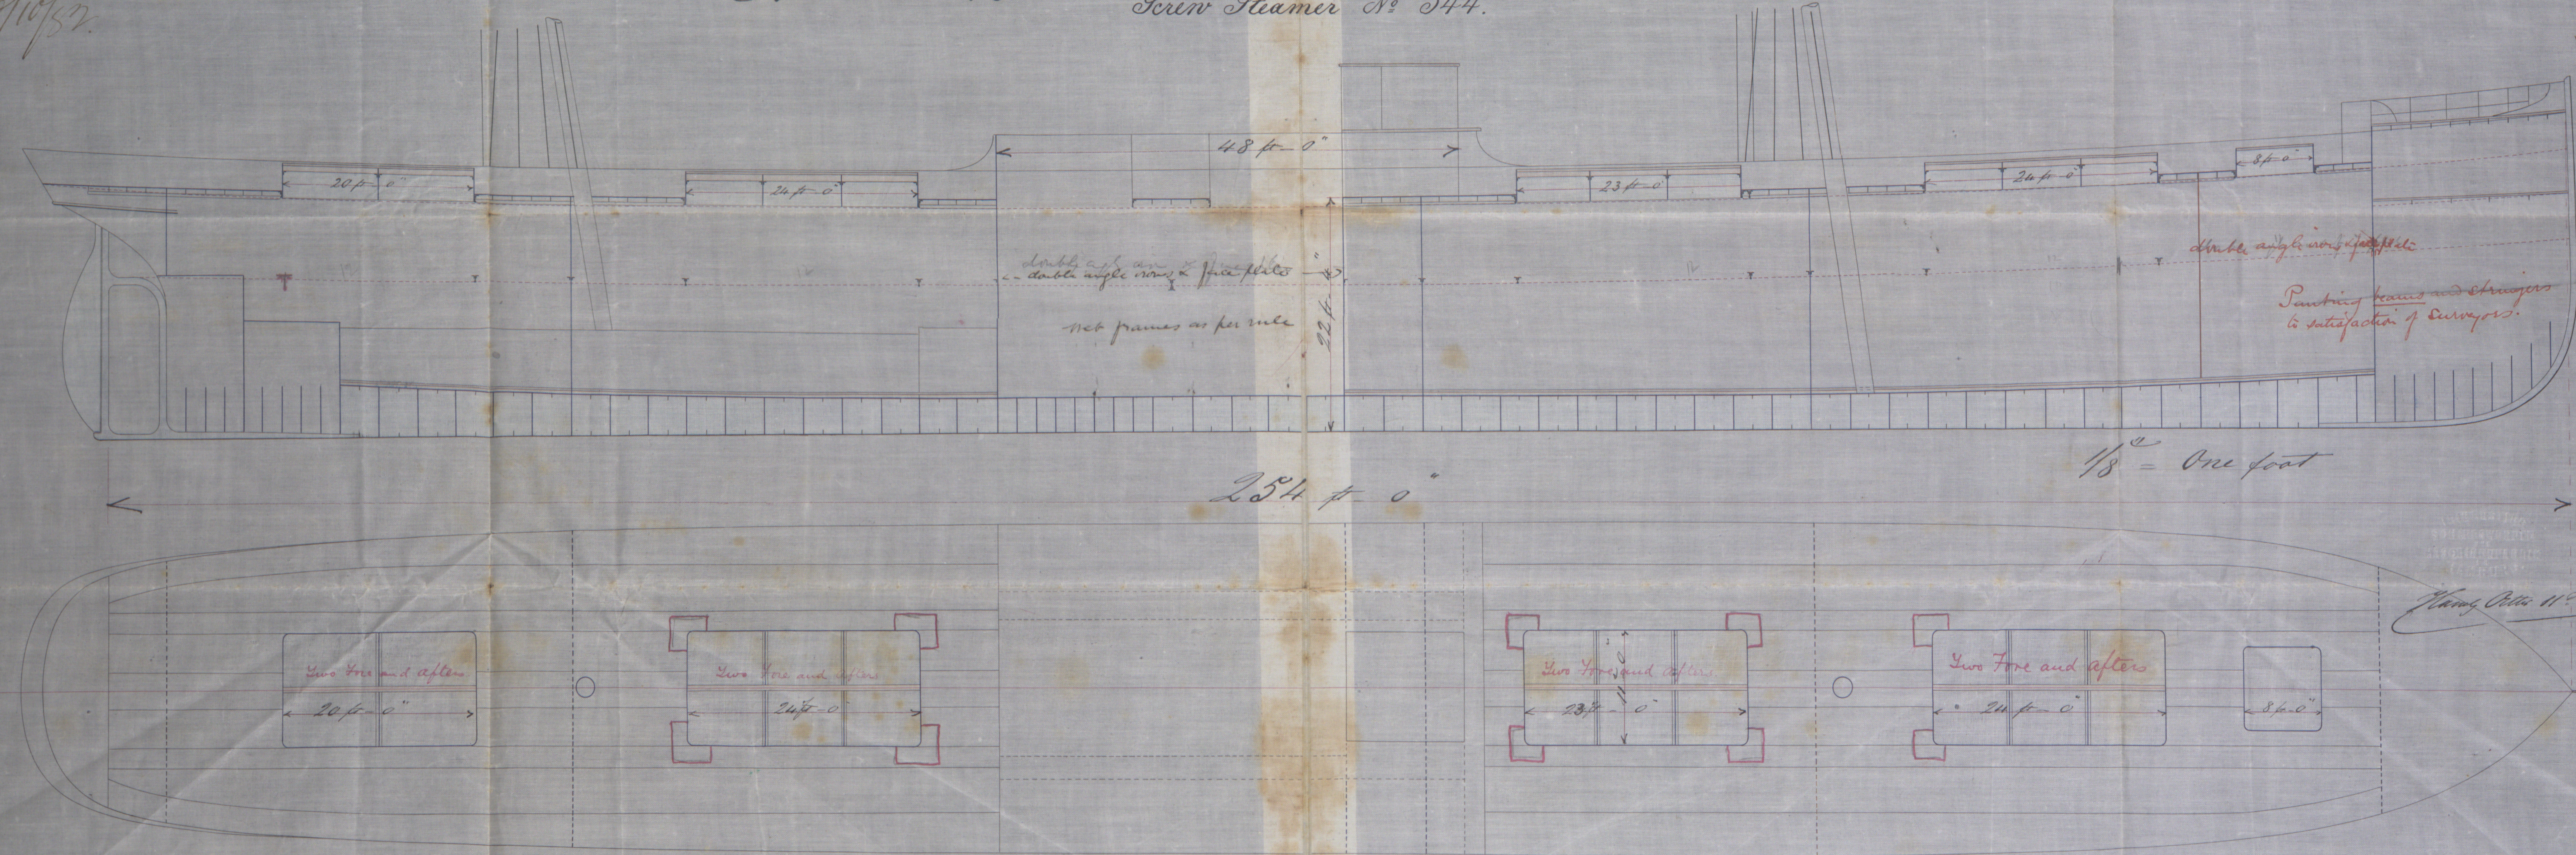

10/10/82

Henry Otto 11/2 1882