


S.S. "Union" Report No 625
 S.S. "Tides" " 626

Elevation S.S. Nos 105 & 106
 $\frac{1}{8}" \approx 1'$

Dr. J. H. Ham
 1883

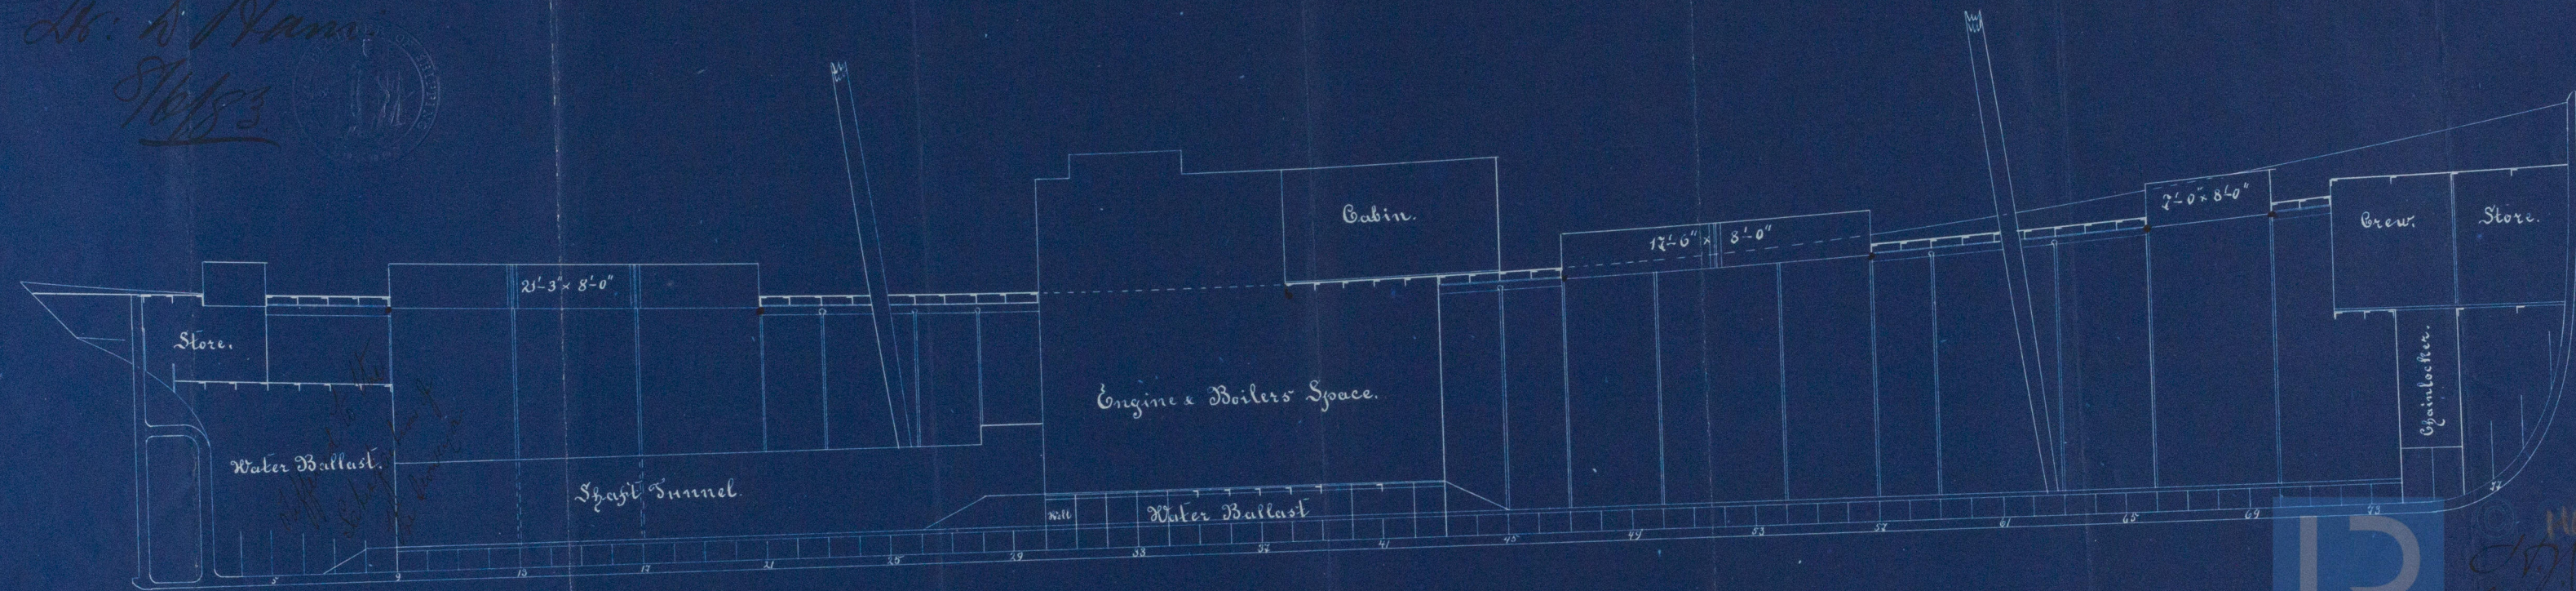

© HAMM-0191
 1883
 Register
 Foundation