


RECEIVED 23rd JAN. 85

Dr. to Ham:

24/1/83.

Plan and Longitudinal Section  
of a  
Screw Steamer No. 346.

J.S.S. Napoli. Report No. 640

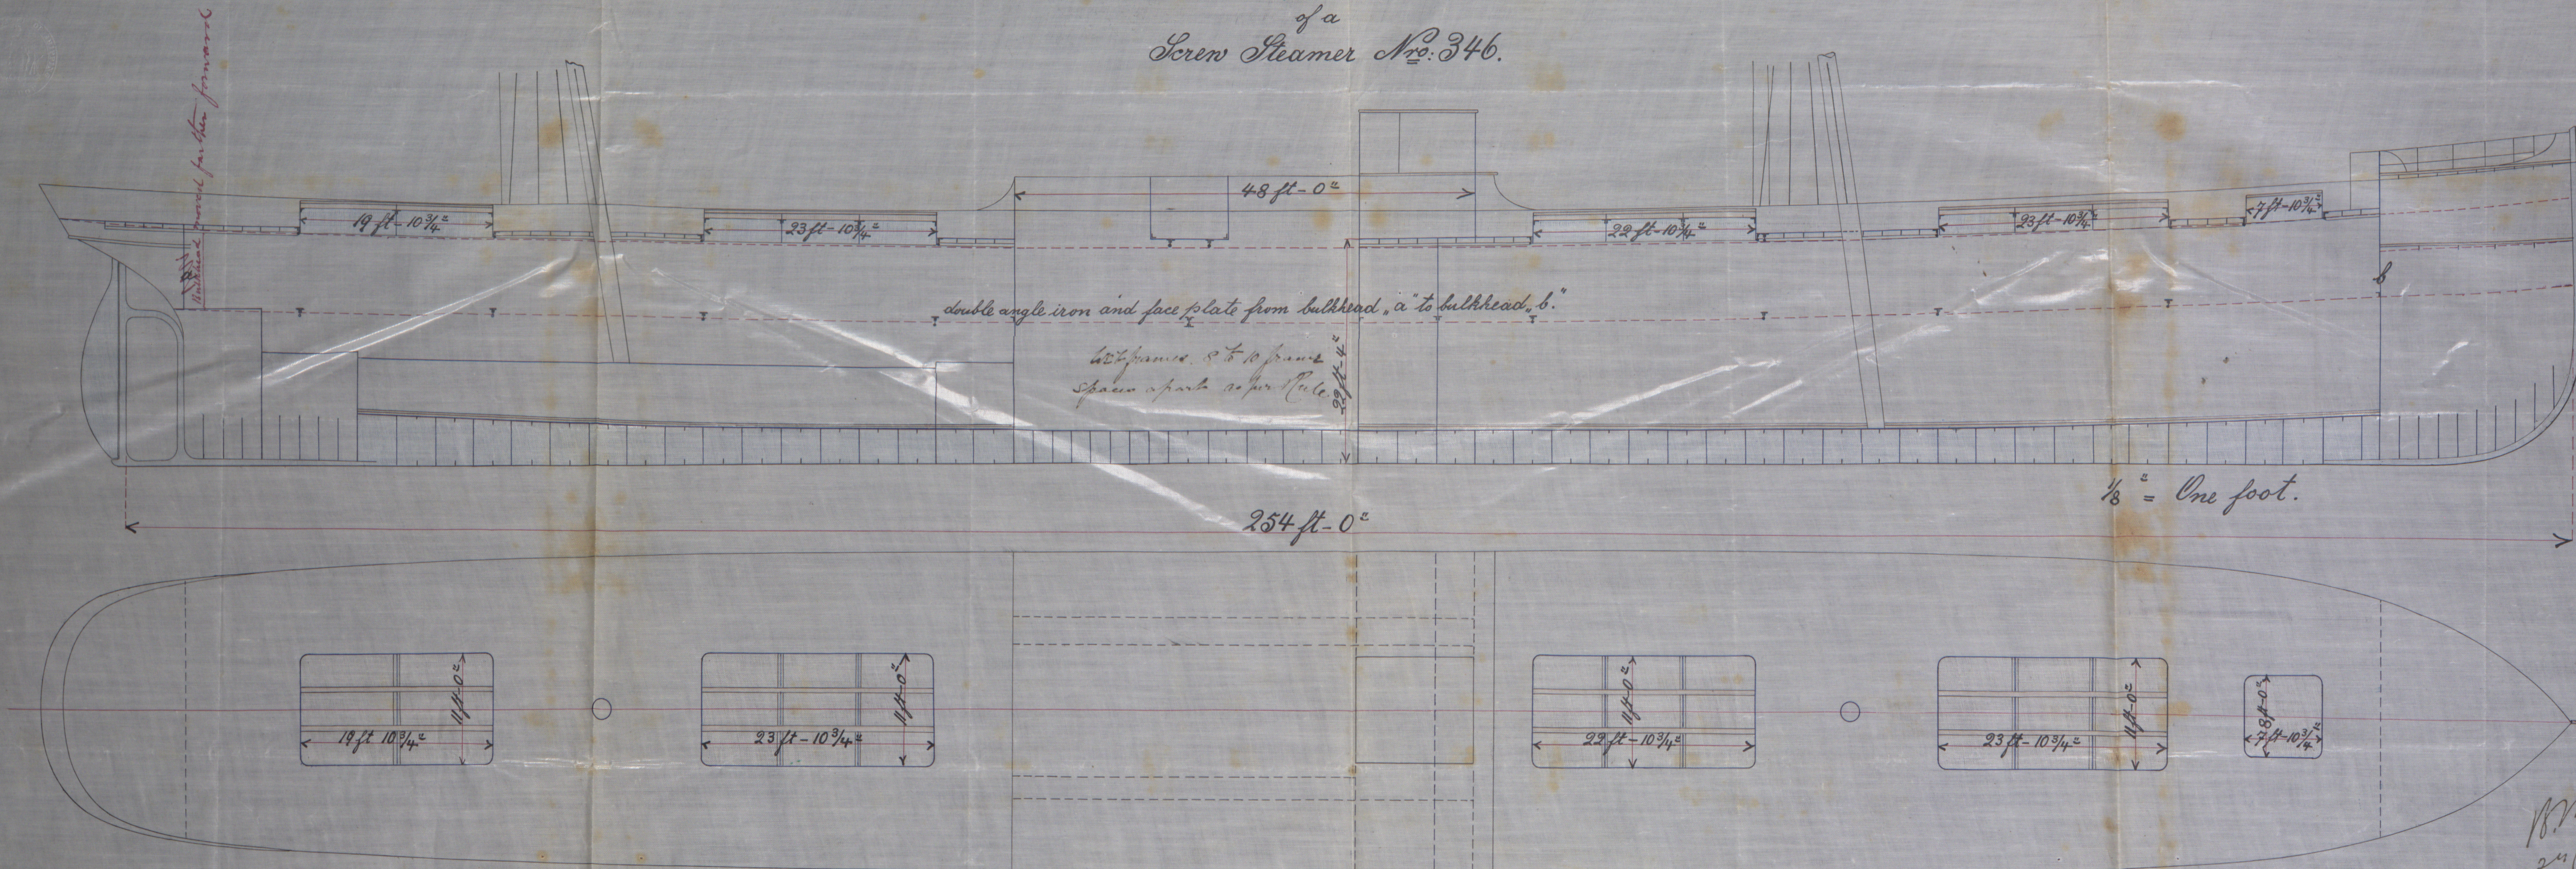

Wm  
24/1/83