
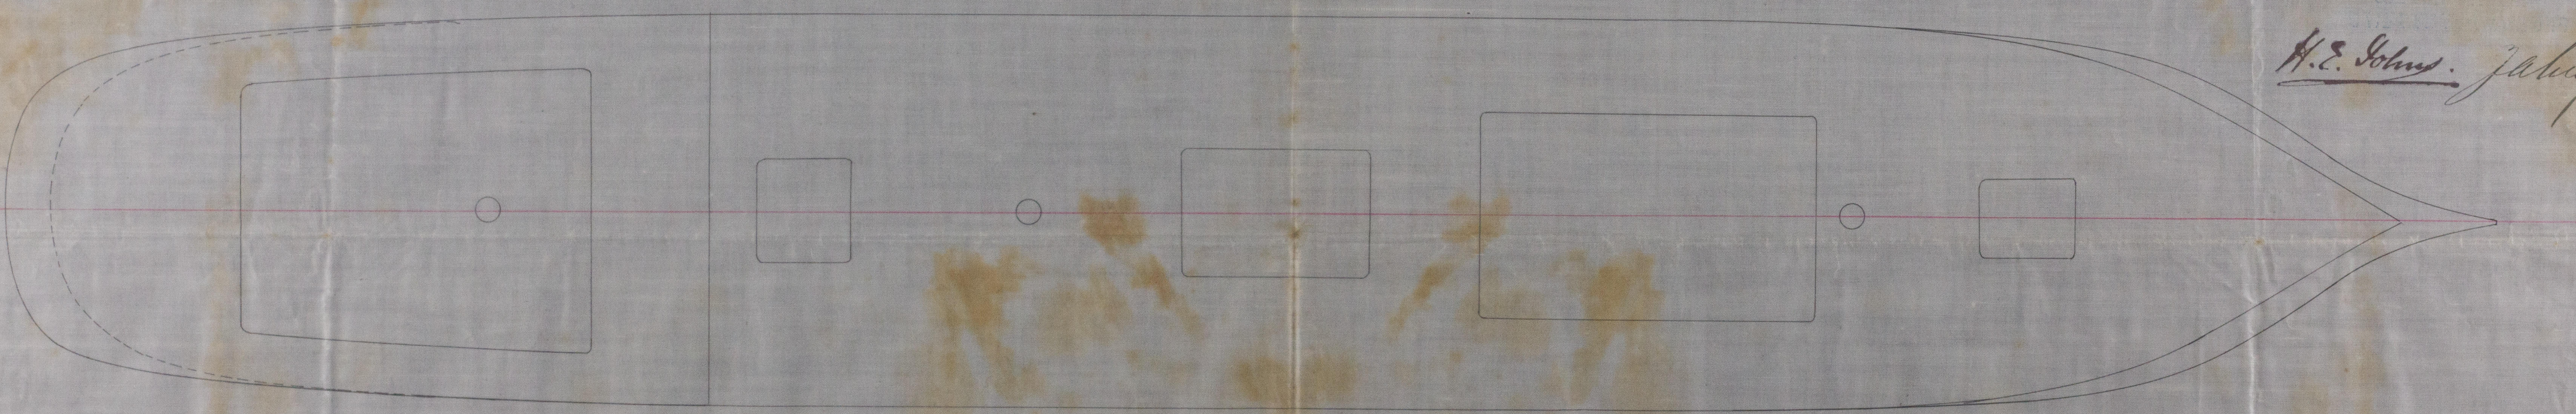


44/84.
16 JAN. 84
LONDON

Dr. R. Main:
17/1/84.

S. S. 4219 J. B. "Mercator"
Scale 1/8" = 1' length. Report No 710.

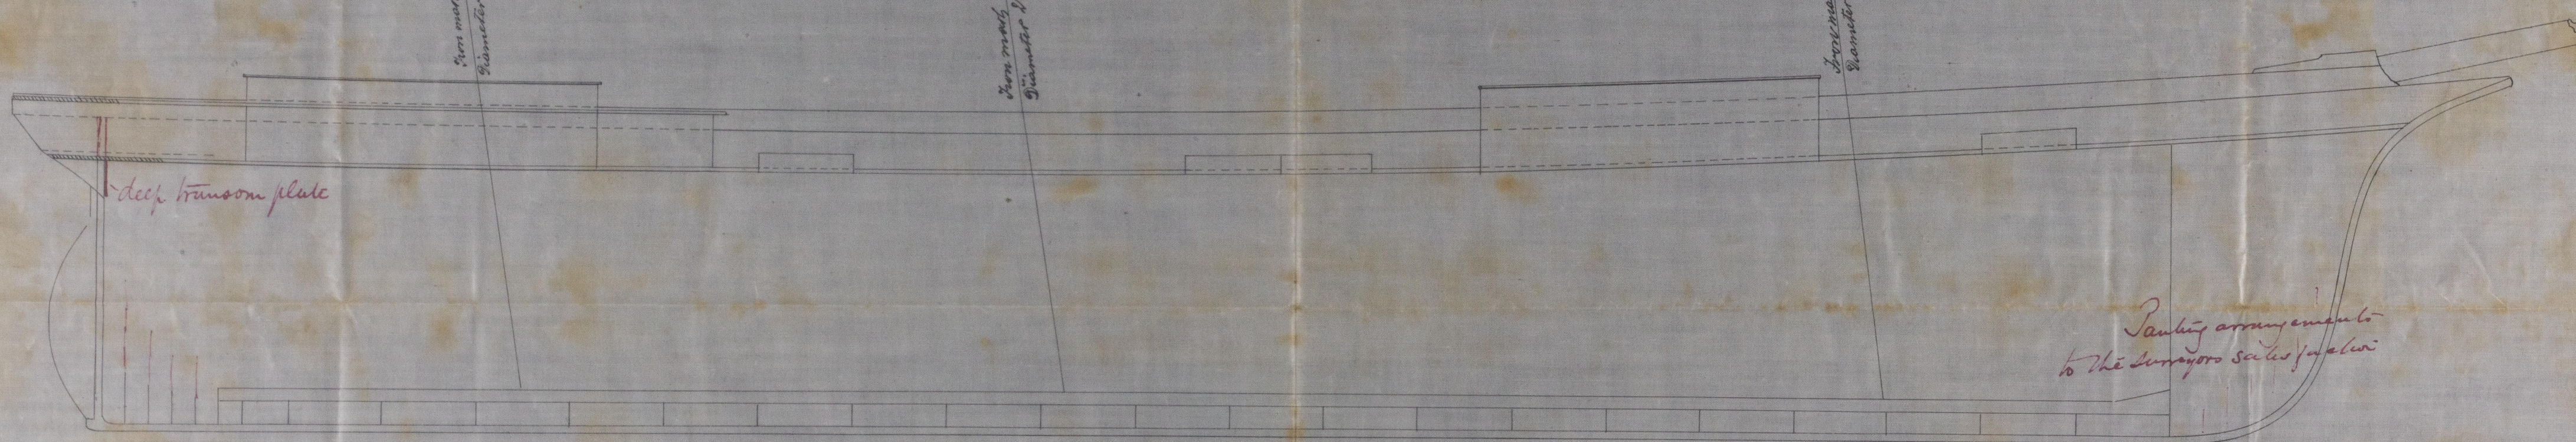

H. E. Johns. J. B. Main


Dr. 17/1/84

HM 1118-0548

10/11/90

No 19. Engr. Lloyd

Engr. Lloyd

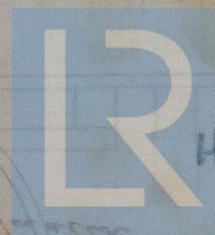

© 2019

Lloyd's Register
Foundation

Engr. Lloyd