


Screw Frame of the S.S. Wilhelm
Red shows the strengthenings.

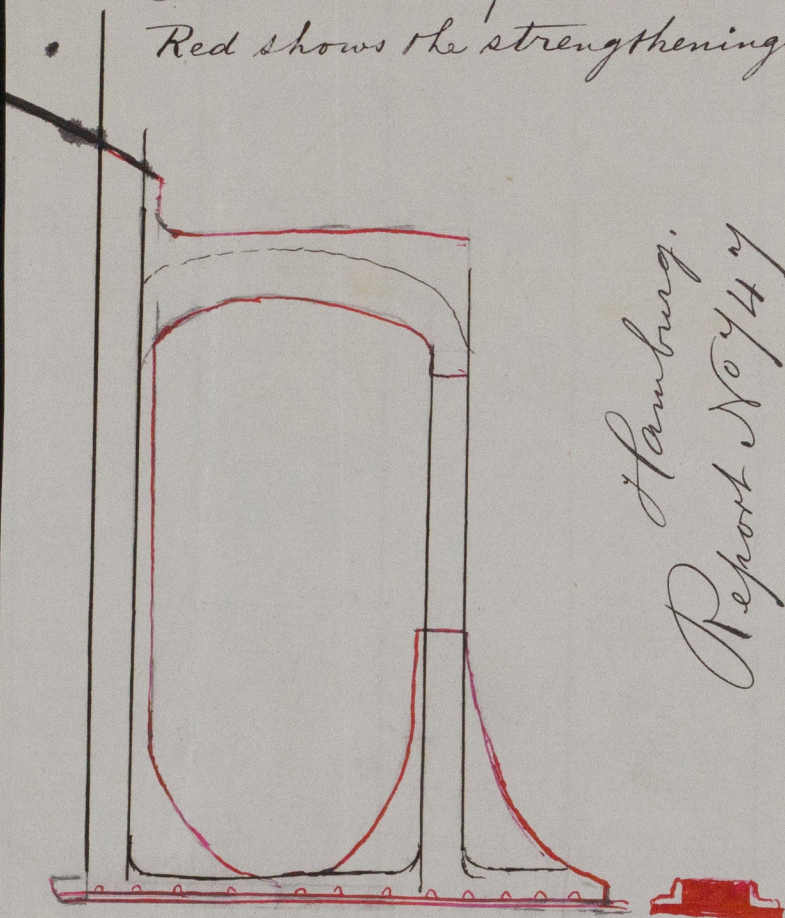

Hamburg.
Report No 447



© 2019

Lloyd's Register
Foundation

HAWTHORNE - 0263