


No 358.

Screw Steamer with raised quarterdeck bridgehouse & forecastle.

Hamburg.  
J. S. S. Stockholm  
Report No 7/64.

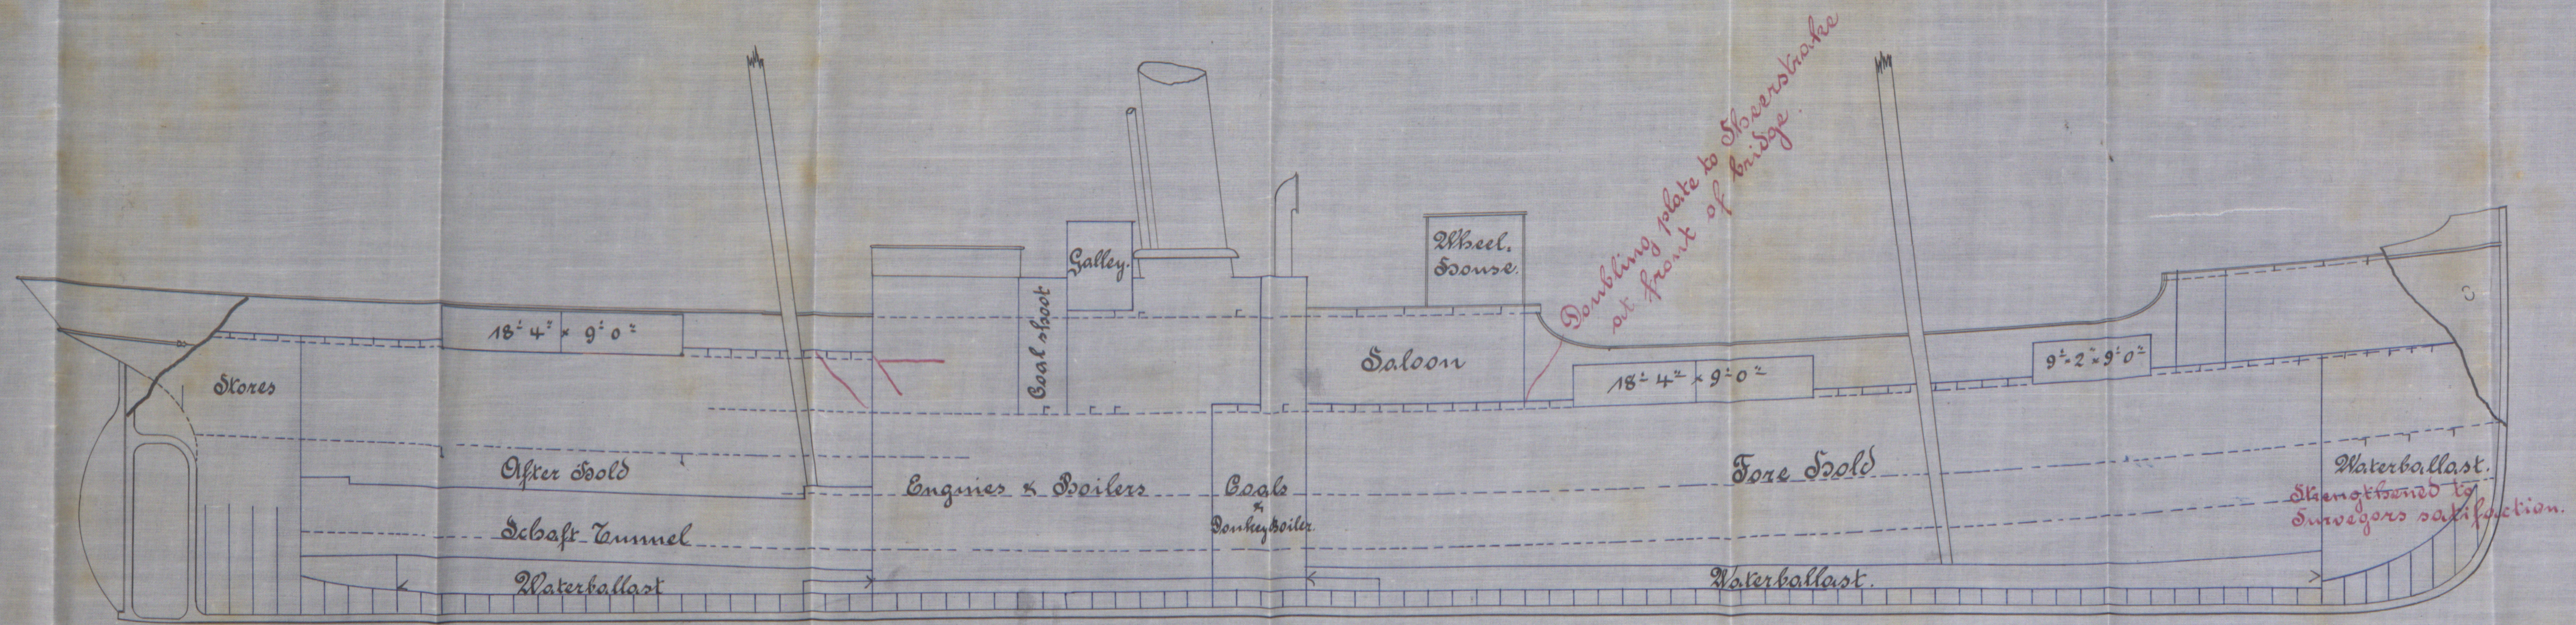

Scale : 1/8 inch = 1 foot. c.m.

7/8/84.