


Longitudinal section for S.S. No. 92 & 93.
Scale $\frac{1}{8}$ " = 1 Foot. -

Steel S. S. Daphne
Report No 1109

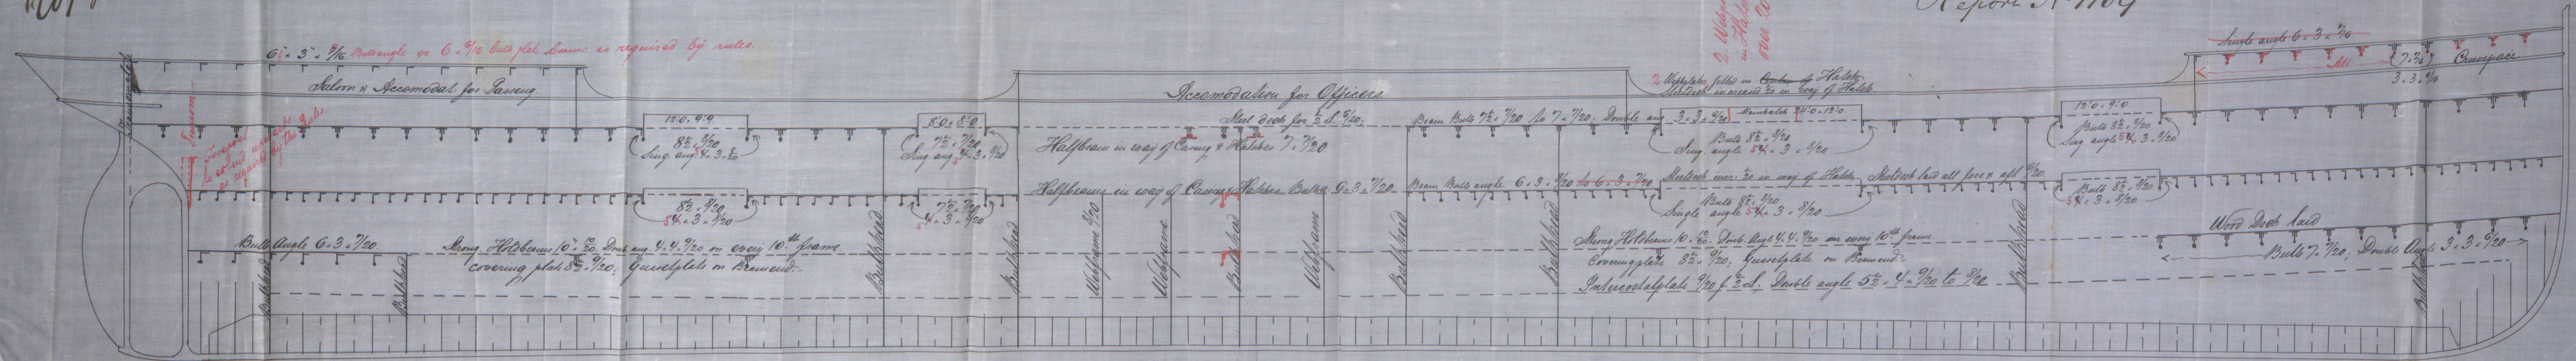

© 2019
Lloyd's Register
Foundation