


FLENSBURGER  
Nr 5921  
BAU-GENESES

J. P. L.  
1871/88

Longitudinal section for SSN: 99.  
Scale  $\frac{1}{8}'' = 1'$ .

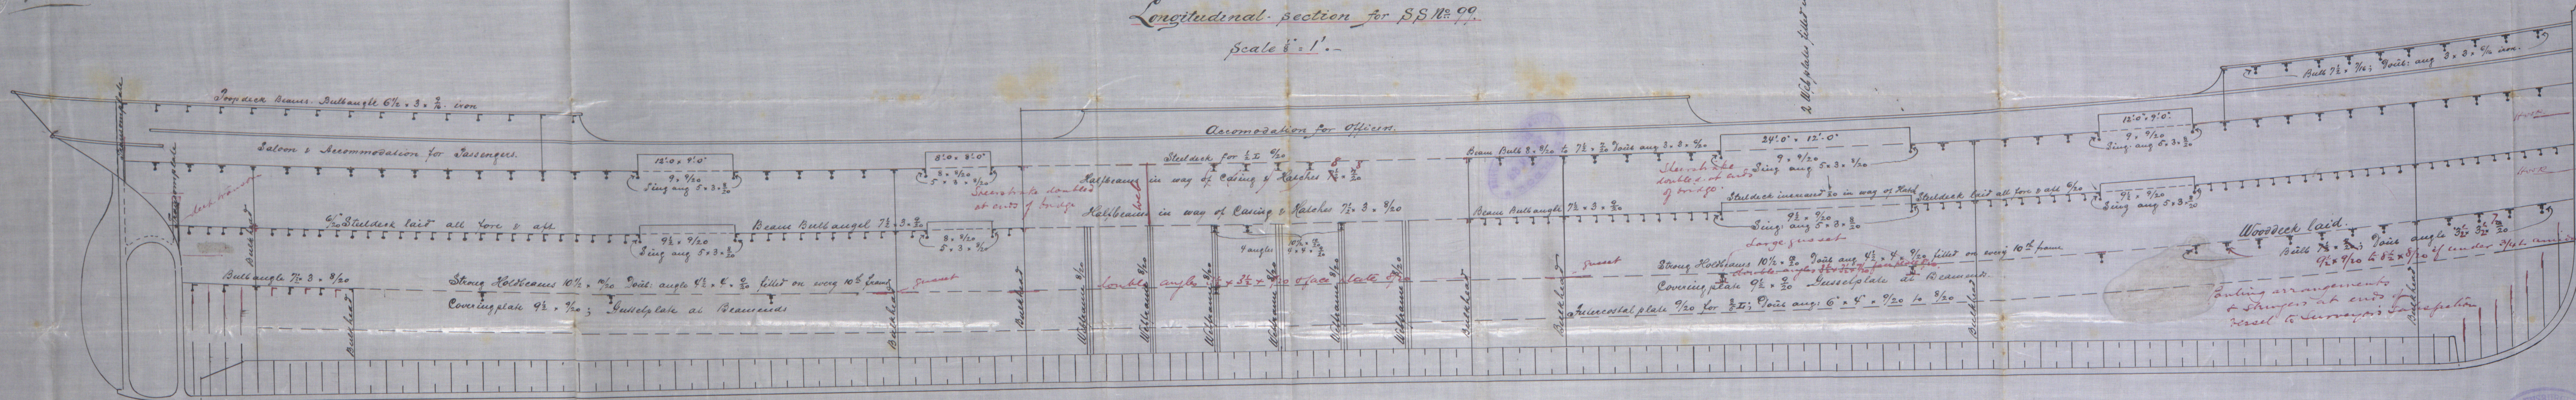

FLYNSBURGER  
12.1.88.  
© 2019  
Lloyd's Register  
Foundation




50/100

1/2 x 1/2 x 1/2

© 2019

Lloyd's Register  
Foundation

HAMUW-0148

