

12/24/88.

8. №: 61.


Length . . . . . 234'-0"

Breadth . . . . . 38'-0"

Depth from top of keel to top  
of upperdeck beams. . . 22'-10"

Scale  $\frac{1}{2}" = 1'$ .

Steel Barque  
"Totodarn"  
Ham Report No 1315

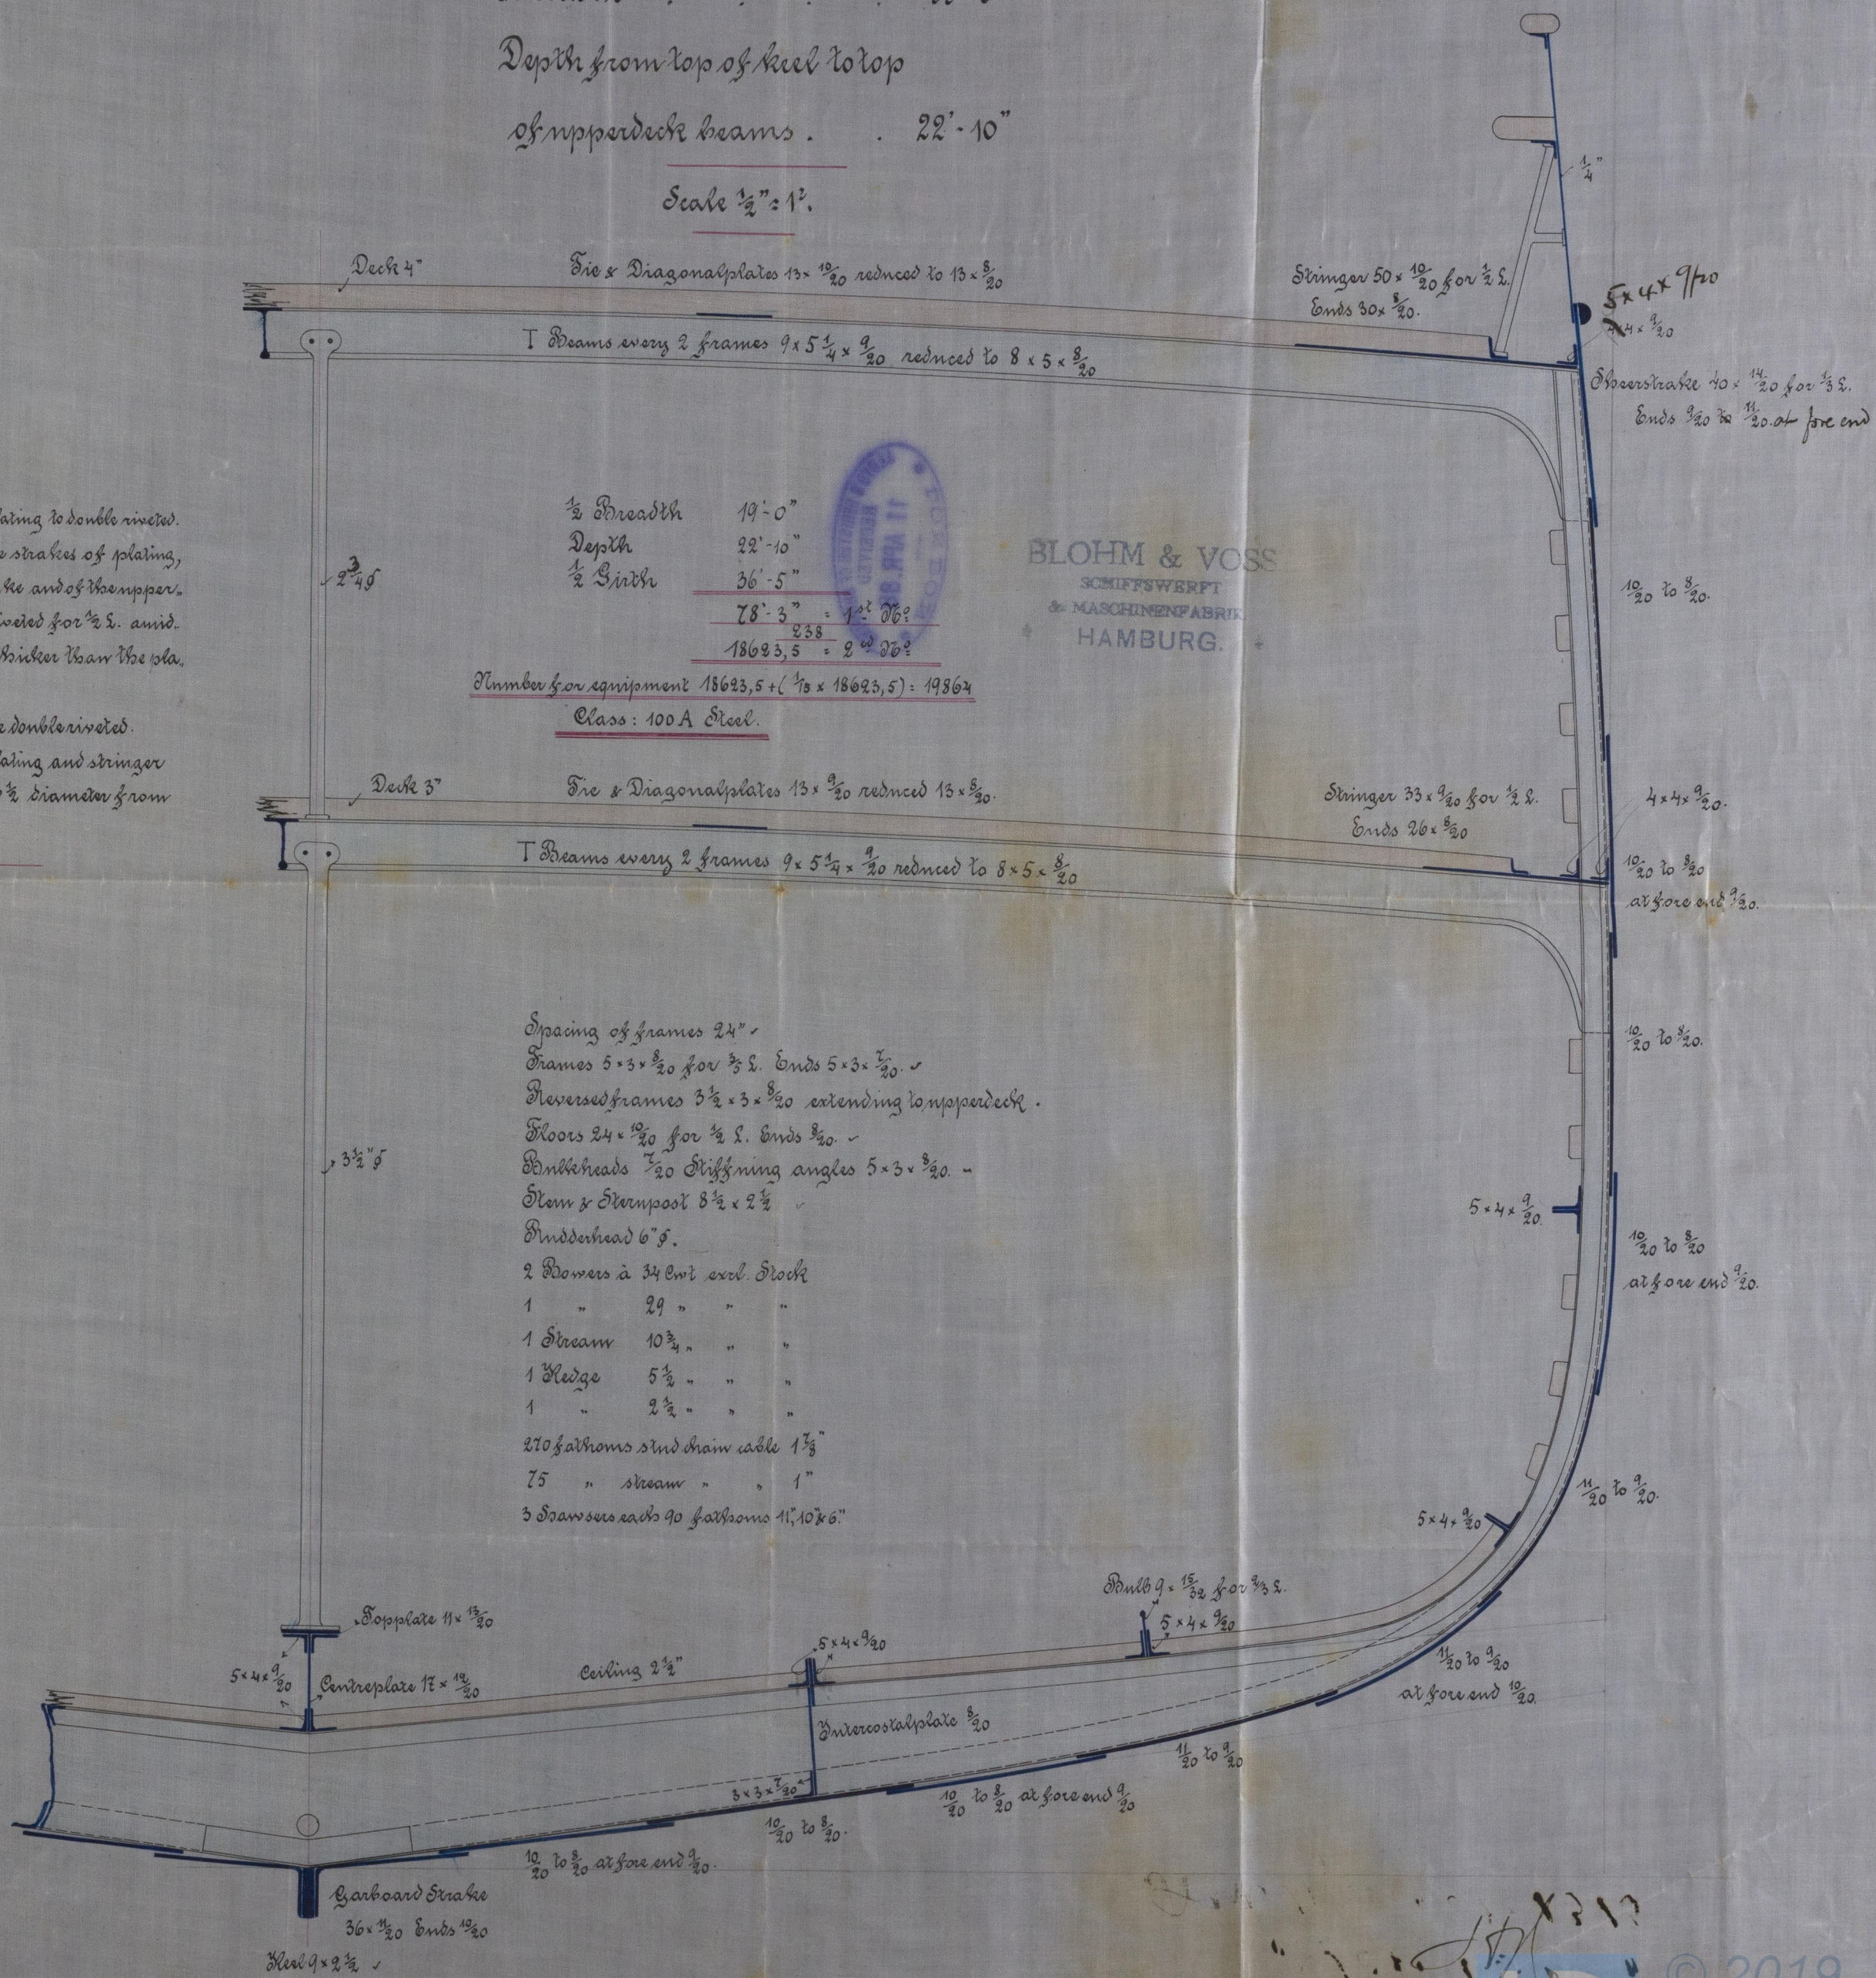

All lantings of outside plating to double riveted.  
The butt straps of the outside strakes of plating,  
of 3 bulge strakes, skewstrake and of the upper  
deck stringer to be double riveted for  $\frac{1}{2}$  S. amid-  
ships with straps  $\frac{3}{8}$ " thicker than the pla-  
tes they connect.

The remainder straps to be double riveted.

Rivets in ends of shellplating and stringer spaced not more than  $3\frac{1}{2}$  diameter from centre to centre.

BLOHM & VOSS  
SCHIFFSWERFT  
& MASCHINENFABRIK  
HAMBURG.

Lloyd's Register  
Foundation

HAMILT 0160



242

0  
1  
2  
3  
4  
5  
6  
7  
8  
9

