


Scale $\frac{1}{2}" = 1$ ft.

Ham 1406

<u>Dimensions:</u>	Register Length	235	0
	Lloyd's Length	225	6
	Breadth moulded	37	11
	Depth of Hold	21	9 1/2
	Depth moulded	25	0 1/2

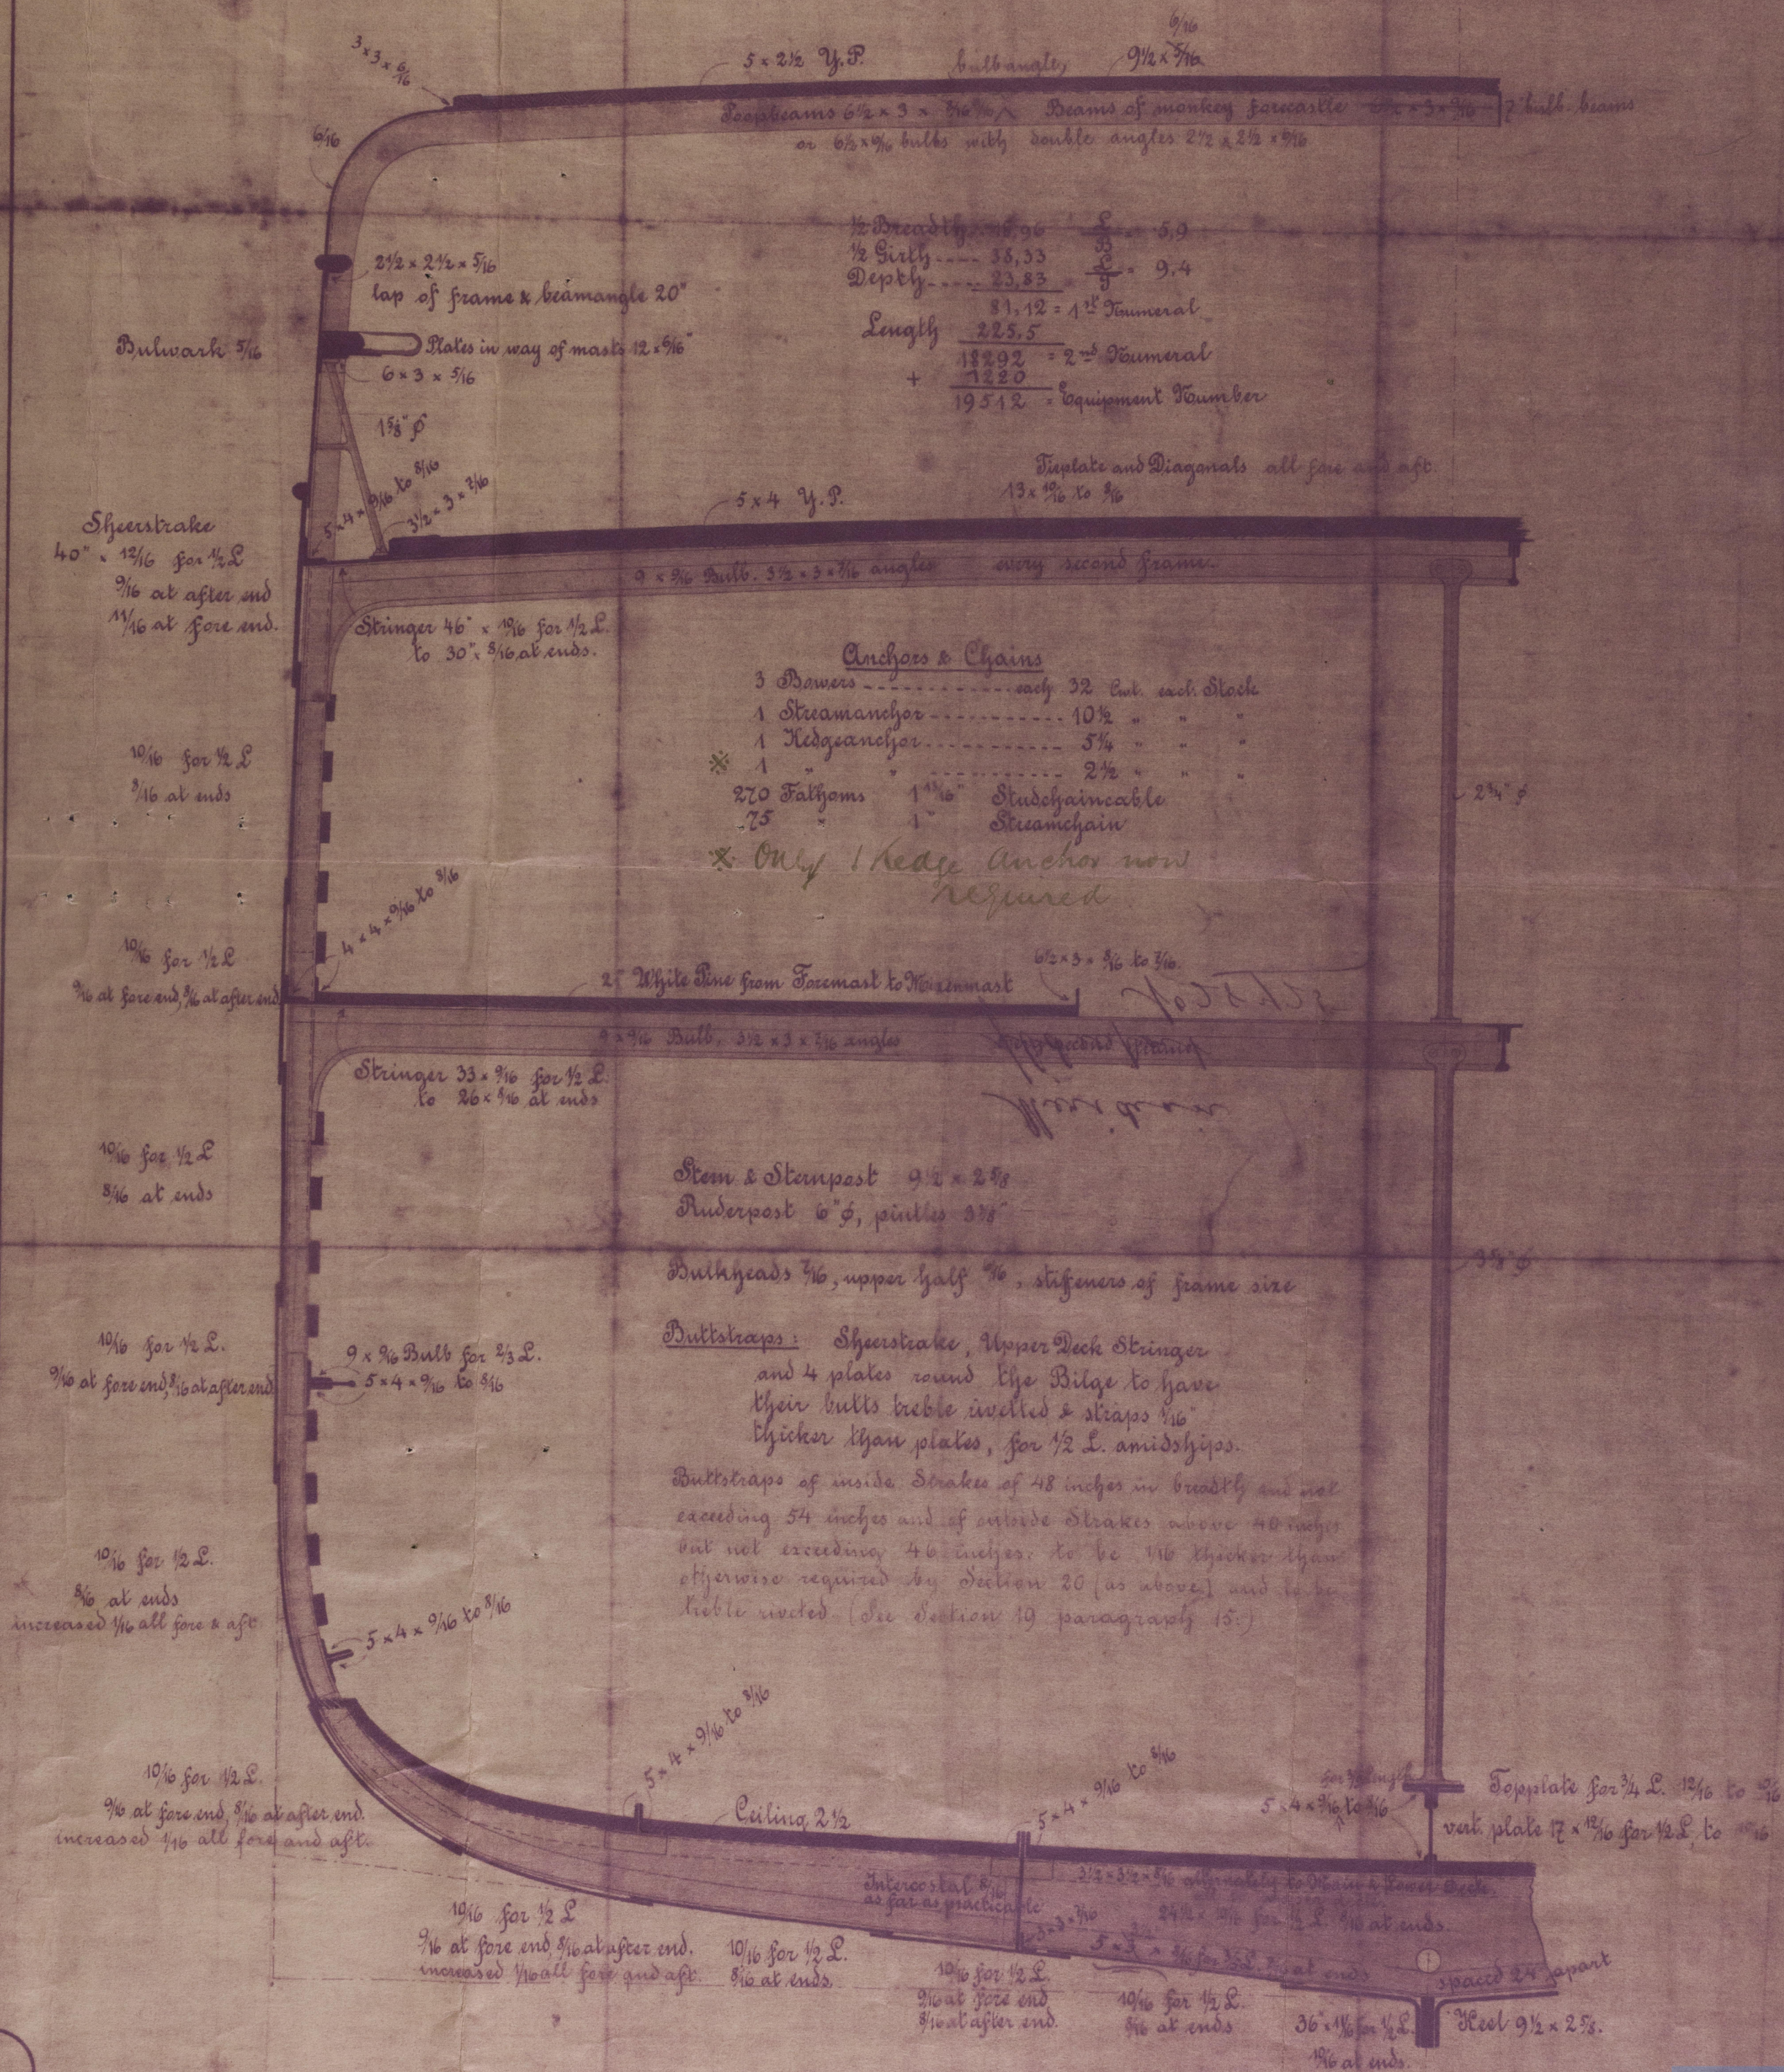

Advised: " Gino

RON. BK ~ LETIZIA ~

— MIDSHIP SECTION —



© 2019

Lloyd's Register
Foundation

#AM11A-0180