


Steel Ship Palmyra
Report No. 1458

Masks & Yards S. No 66

Scale $\frac{1}{2}$ inch = 1 foot

Note! The distance of rivets equal to three times and a half the diameter of same.
All butt straps $\frac{1}{2}$ of an inch thicker than the plates they are to connect.




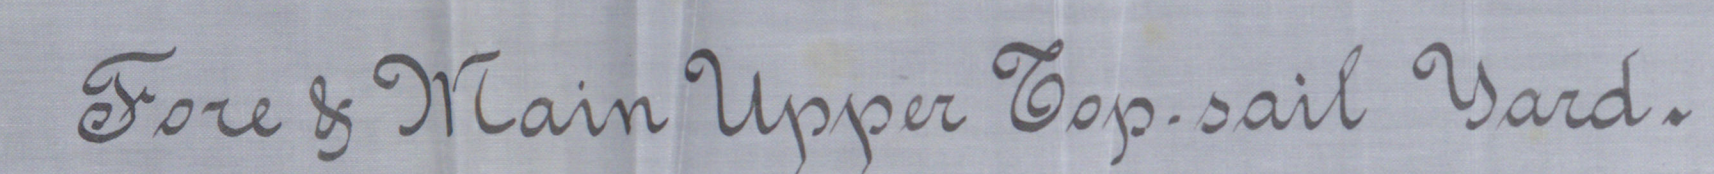


Fore & Main Lower Yard.

Nizen. Bast.

Fore- & Main-Mask.

Fore & Main Upper Top-sail Yard

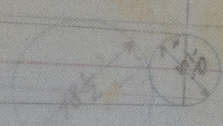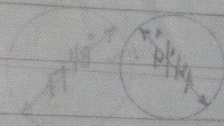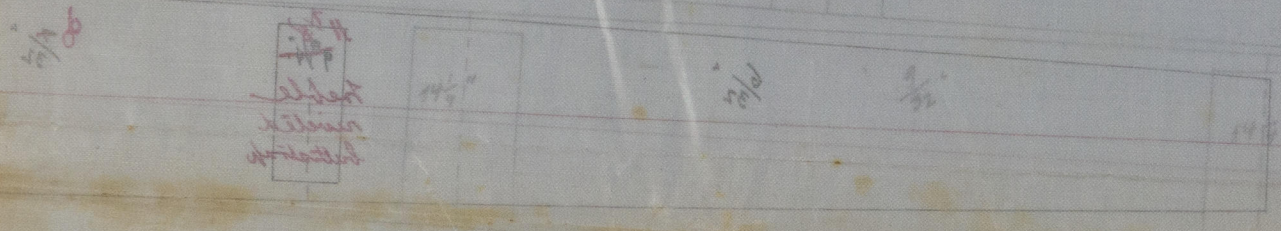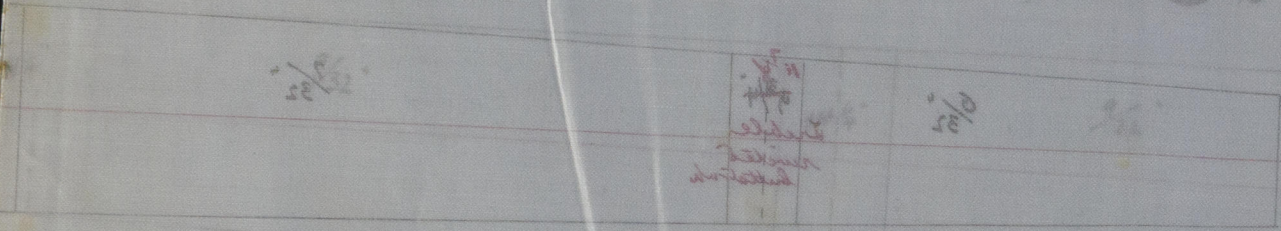


Couplings
74-0












... and a half the diameter of same
... are to connect

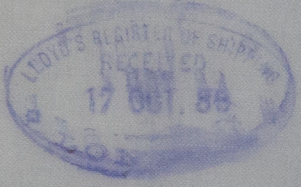

Fore & Main Lower Yard

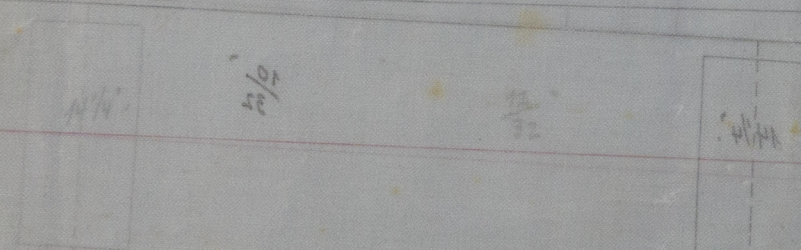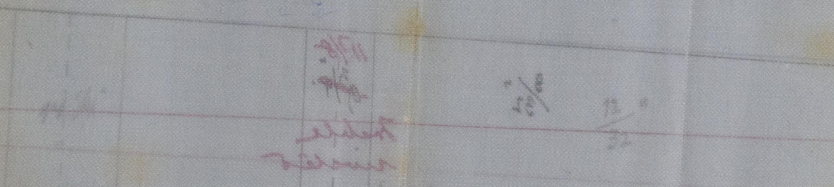

Couplings
88-0

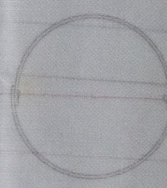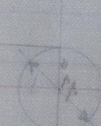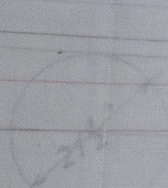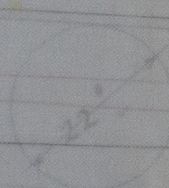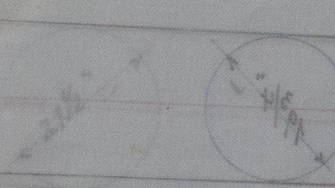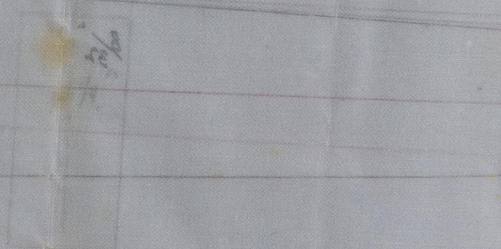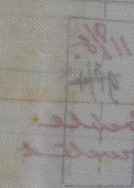

BLOHM & VO
KREUZWEIT
& MATTHESEN
HAMBURG.

Wizen-Block



© 2019

Lloyd's Register
Foundation