

LONDON
OCT 10 1888
REGISTERED

THU 14 OCT 88


S. No: 66.

Lloyds Class: 100 A Steel.

Scale $\frac{1}{8}'' = 1'$

BLOHM & VOSS
SCHIFFSWERFT
& MASCHINENFABRIK
HAMBURG.

Steel Ship Palmyra
Report No 1458

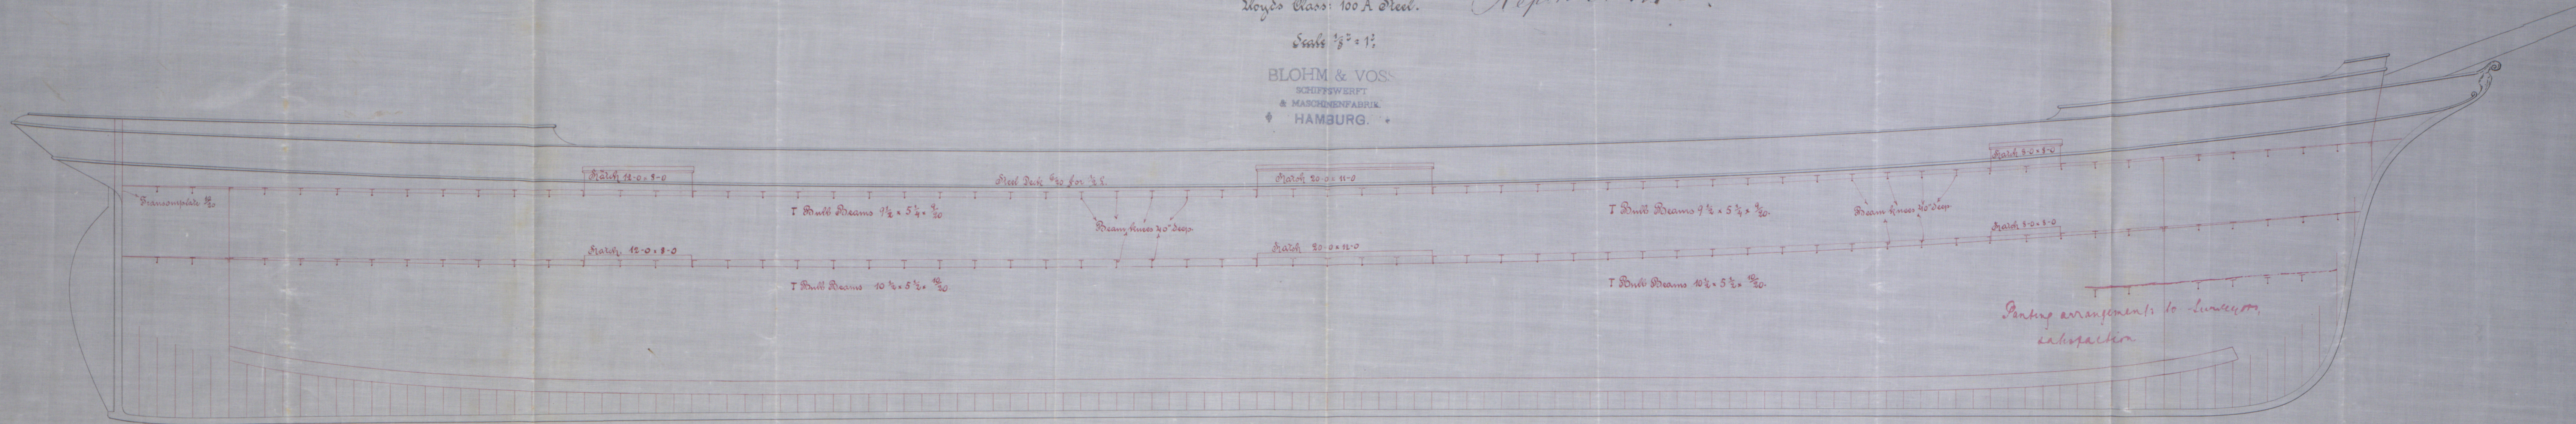



88 T304 UHT



© 2019

Lloyd's Register
Foundation

HAM 1117-0226