


Report No 1781 S.S. Schönbürg

Longitudinal-section for S.S. Nos. 116 & 117.  
Scale  $\frac{1}{8}'' = 1'$

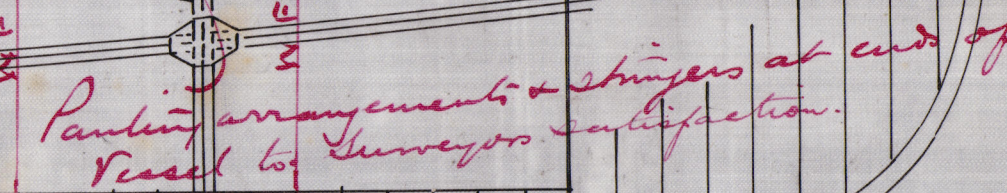

18m  
8/1/90

6 LR 31.12.89 7457 Lloyd's Register Foundation


HAM1118-0056



MEB 8 27/11/15

31.11.15  
7457


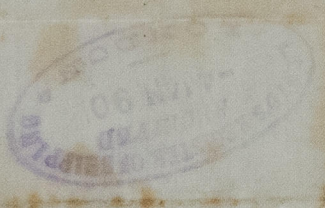

*Schönburg*  
*Hamb 1787*

HAMBURG - 0056

HAMBURG - 0056



© 2020  
Lloyd's Register  
Foundation