


Scale $\frac{1}{2}'' = 1'$

221' 0"
- 37' 0"
- 22' 8"
- 21' 11½"

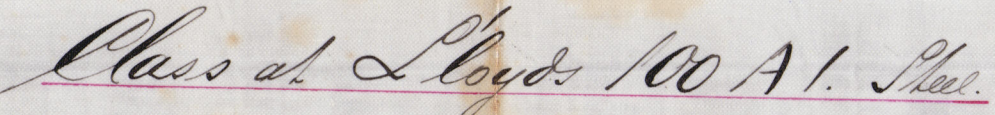

Half Break's	18.50
Seeds	22.67
Half birds	36.25
	<u>77.42</u>
L.L.	1.25
	<u>221.00</u>
	17110 = 22.98
+ 1/10 =	18251 = Exp. 9.
I/D = 9.75.	<u>LB = 5.98!</u>

Maindeck.

WOODPECKER.
 Minus ex plate $44 \frac{10}{100} = 29 \frac{8}{20}$
 Plus 2 Diagonals $13 \frac{10}{100} = 9 \frac{1}{20}$
 Minus triangle $4 \frac{1}{2} = 4 \frac{1}{2} \frac{9-8}{20}$
 Gutter angle $3 \frac{1}{2} = 3 \frac{1}{10}$
 Woodch 4; Pinewood, Margins, back Leaf.

Anchor & Chains & Hawsers

2 Bombs excl. Hook	52 Cords
1 Steam anchor " "	27 $\frac{1}{2}$ "
1 Trestle " "	10 $\frac{1}{2}$ "
1 " " " "	5 $\frac{1}{2}$ "
270 Fath. Lead Chain Cable	2 $\frac{1}{2}$ "
Steam Chain 75 Fath.	1 $\frac{1}{2}$ Dia.
Hawser 90 Fath	11 " 9 $\frac{1}{2}$ " 6. "

MS 7879
20. 10. 90