sailing sh. "Helios" Report No. 2042
(No. 122)

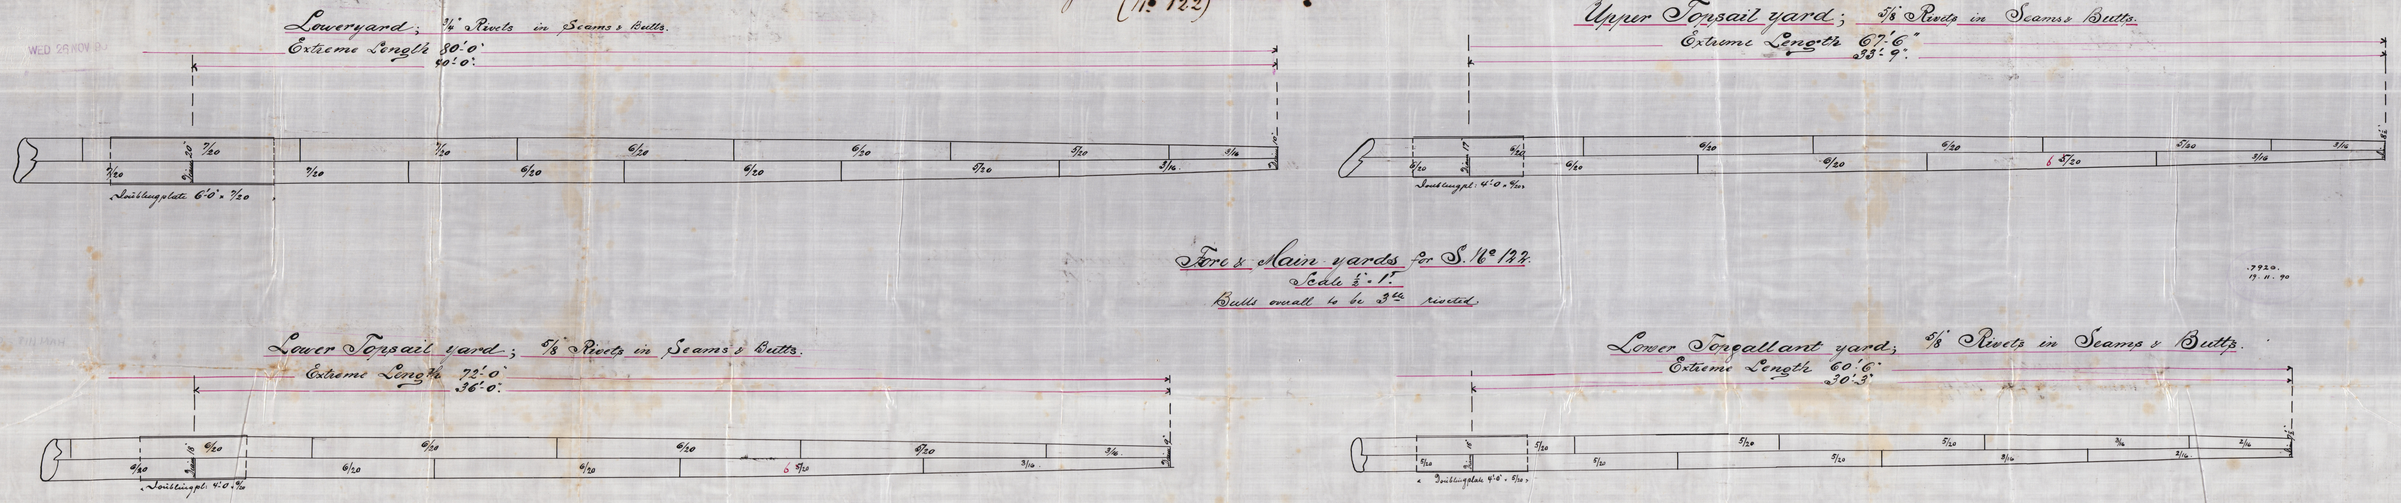

25/11/90

© 2020 Lloyd's Register Foundation
HAM1118-0142