Rep.

Longitudinal section for Sailing Ship No 122.

Scale 8" = 1 Foot.

Helios No 204-2

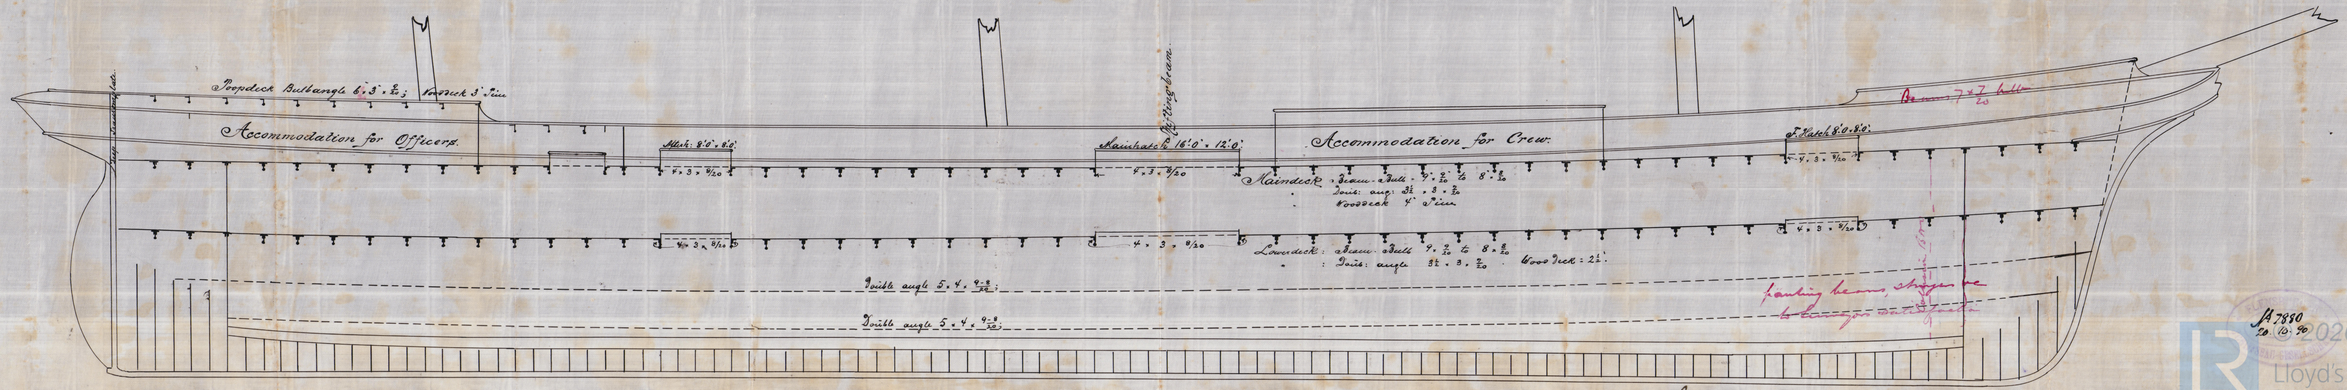

A 7880
20.10.90
© 2020
Lloyd's Register Foundation
HAM1118-0143