


WED 20 NOV 93





Helios 11: 2042 Report

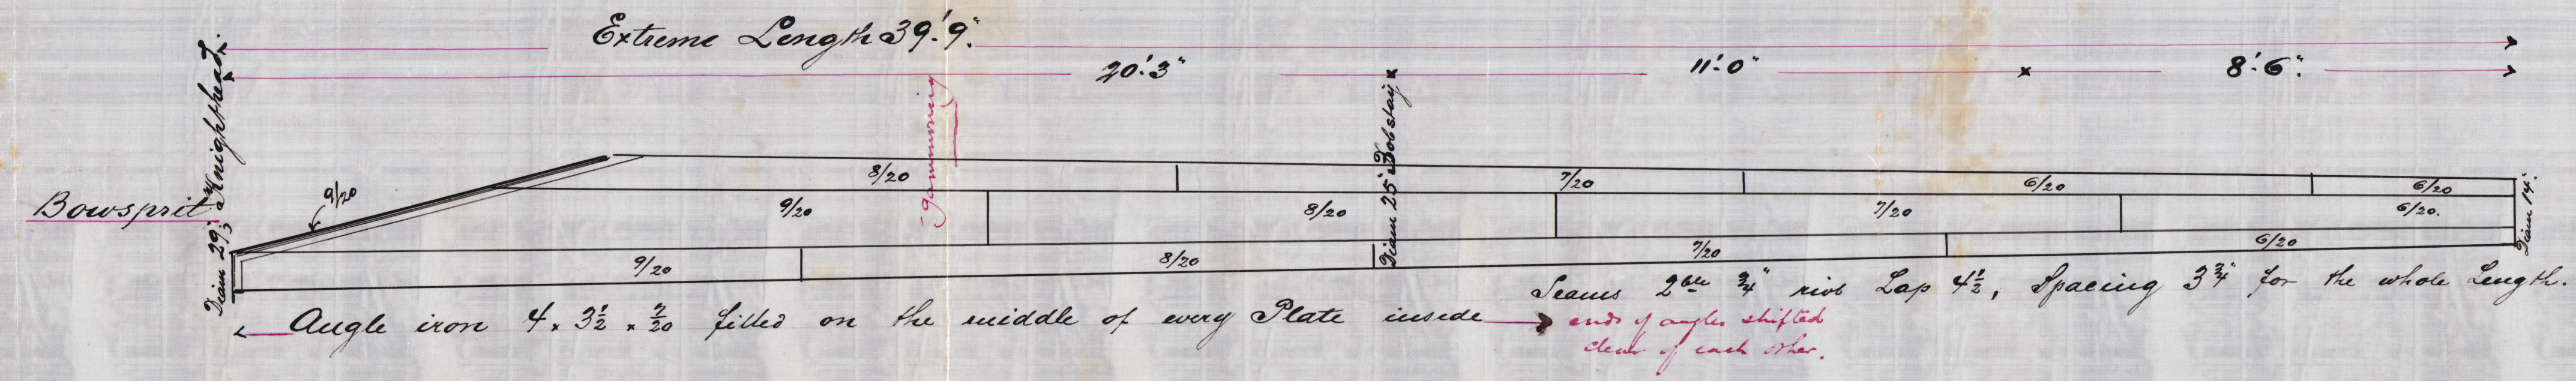


Masts & Bowsprit for S. 11: 1997; made of 3 plates in circumference
all shells to be 3 1/2 x 3/4 rivet with exception of those marked 2 1/4;
Scale 1/2" = 1'

Helios makes hulls
for these masts
since she is the

 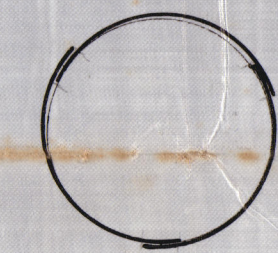

For a main mast additionally
stiffened from below lower part to above
lower top rail yard.

7921.
11-11-90

 

107
25/11/90