

Lloyd's Register of British and Foreign Shipping.

Hamburg

(Report on Vessel No. *122* Port *Hamburg*)

No. *1891.a.*

SHIP FORGINGS OR CASTINGS.

Hamburg *2042*

"Helios"

I have to report that the undermentioned Iron or Steel Forgings or Castings, manufactured by

Mr Tho Ray

of *Pallin*

for the Vessel No. *122*, being built by *the Hamburg S B Co.*

of *Hamburg* have been inspected by me as set forth below, and found

to be, so far as can be seen, *sound.*

The words FORGINGS or CASTINGS, IRON or STEEL, should be struck out as may be required.

Mark on Forgings.


Lloyd's
No. *1891.a.*
10.6.

Hugh Cannon

Sunderland
25/4/91

	STERN FRAME.	RUDDER FRAME.	STEM.
Material*	<i>Scrap iron</i>	<i>Scrap iron</i>	<i>Scrap iron</i>
How made	<i>forged</i>	<i>forged</i>	<i>forged</i>
Dimensions	<i>9" x 2 3/4"</i>	<i>6" x 3 1/2"</i>	<i>9" x 2 1/2"</i>
Progress on Inspection	<i>forged Smithed</i>	<i>forged Smithed</i>	<i>forged</i>
Dates when Inspected	<i>July 19-24 Mauld 21-23/91</i>	<i>Jan 5-13-19-27-30 July 1/91</i>	<i>July 19/91</i>

SKETCHES OF FRAMES SHEWING POSITION AND DESCRIPTION OF WELDS OF FORGINGS, OR PARTICULARS OF TESTS APPLIED TO CASTINGS.

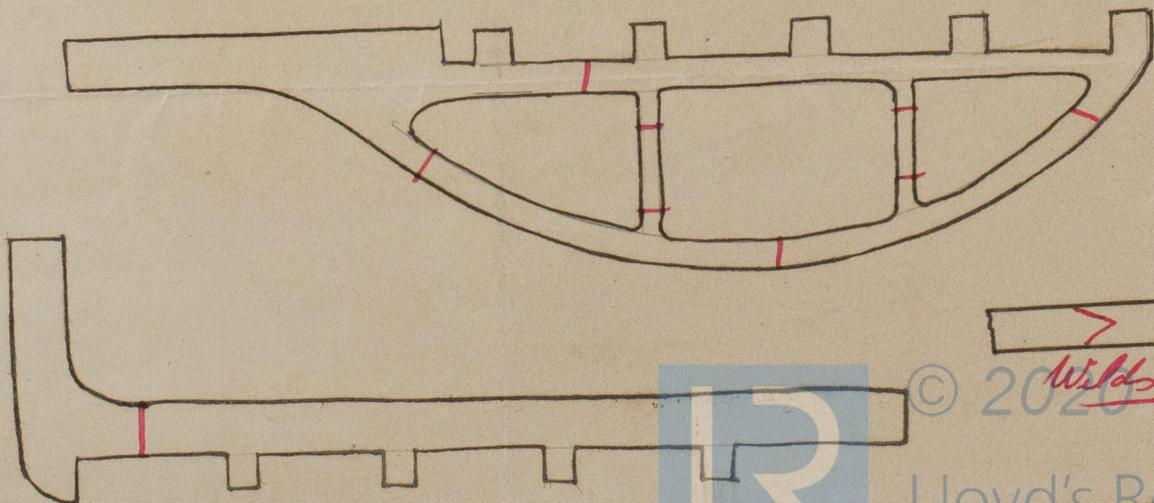

* If of Iron, state whether scrap or puddled Iron.