


10. 9. 92
3. 10. 92

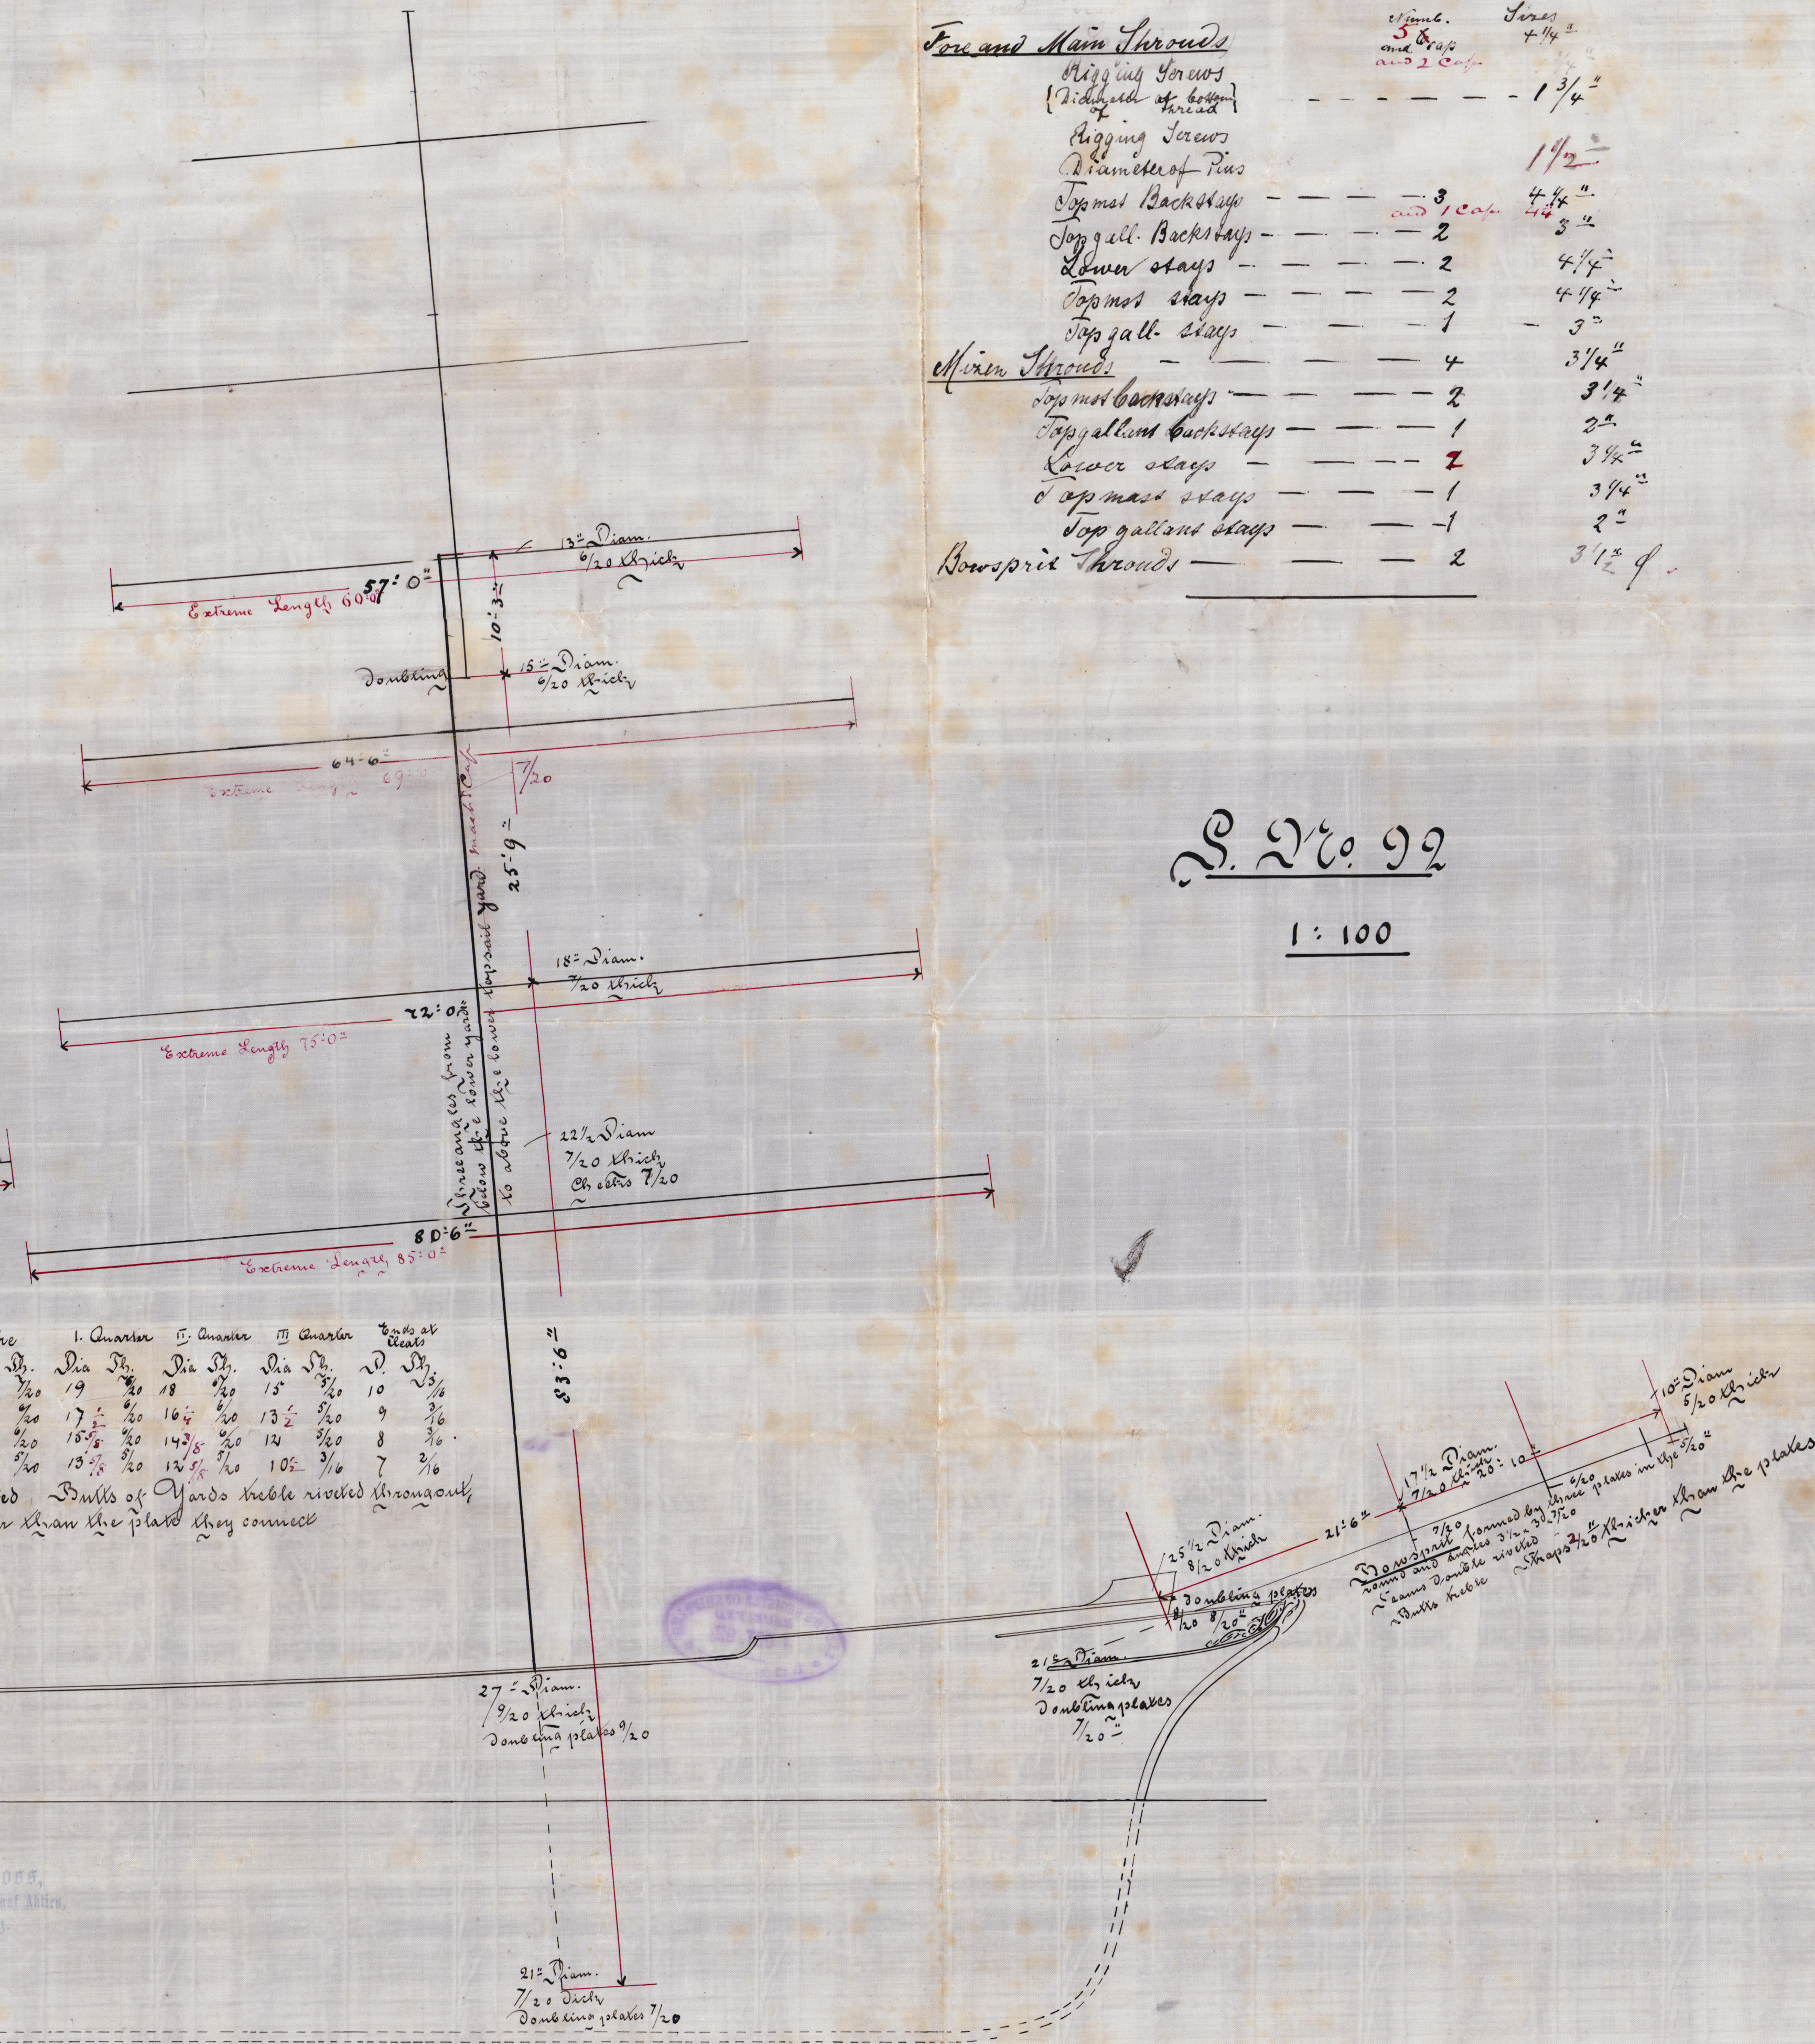

	3/16 in. and 3/32 in. and 2 Corns.	3/16 in. 4/16 in.
<u>Fore and Main Shrouds</u>		
Rigging Forews		1 3/4"
{ Riddle of the beam		
Rigging Forews		1 1/2"
Rigging of Pins		
Topmast Backstays	3 and 1 Corn	4 1/4"
Top gall. Backstays	2	3"
Lower stays	2	4 1/2"
Topmast stays	2	4 1/4"
Top gall. stays	1	3"
<u>Mixer Shrouds</u>	4	3 1/4"
Topmast backstays	2	3 1/4"
Top gallant backstays	1	2"
Lower stays	2	3 1/2"
Topmast stays	1	3 1/4"
Top gallant stays	1	2"
<u>Boresprit Shrouds</u>	2	3 1/2"

S. No. 92
1:100

Yards		Centre		I. Quarter		II. Quarter		III. Quarter		Ends at least	
Lower	Yards	Length	Dia.	Th.	Dia.	Th.	Dia.	Th.	Dia.	Th.	No. of Strs.
Lower Topsoil	"	80' 6"	20	$\frac{1}{2}$ 0	19	$\frac{1}{2}$ 0	15	$\frac{1}{2}$ 0	15	$\frac{1}{2}$ 0	9
Upper	"	64' 6"	18	$\frac{1}{2}$ 0	17 $\frac{1}{2}$	$\frac{1}{2}$ 0	16 $\frac{1}{2}$	$\frac{1}{2}$ 0	13 $\frac{1}{2}$	$\frac{1}{2}$ 0	10
Lower Topgallant	"	37' 6"	14	$\frac{1}{2}$ 0	15 $\frac{1}{2}$	$\frac{1}{2}$ 0	14 $\frac{1}{2}$	$\frac{1}{2}$ 0	12	$\frac{1}{2}$ 0	8
				$\frac{1}{2}$ 0	15 $\frac{1}{2}$	$\frac{1}{2}$ 0	14 $\frac{1}{2}$	$\frac{1}{2}$ 0	10 $\frac{1}{2}$	$\frac{1}{2}$ 0	7

Seams of all Yards single riveted

Bulls of Yards double riveted throughout

Traps of all Bulls "No. 1" better than the plates they connect

Plan of masts &
spars for sailing
ship N^o 92 now
building^{by} Messrs
Plohm & Voss
Hamburg letter 7/9.92

St. Rk "Leestern"
Report N^o 2375

HAM 1118-0182

HAM 1118-0182



© 2020

Lloyd's Register
Foundation