


Scale 1:100

Class: Lloyds 100 A. 1. Steel.

Blohm & Voss,
Commanditgesellschaft auf Aktien,
Samburg.

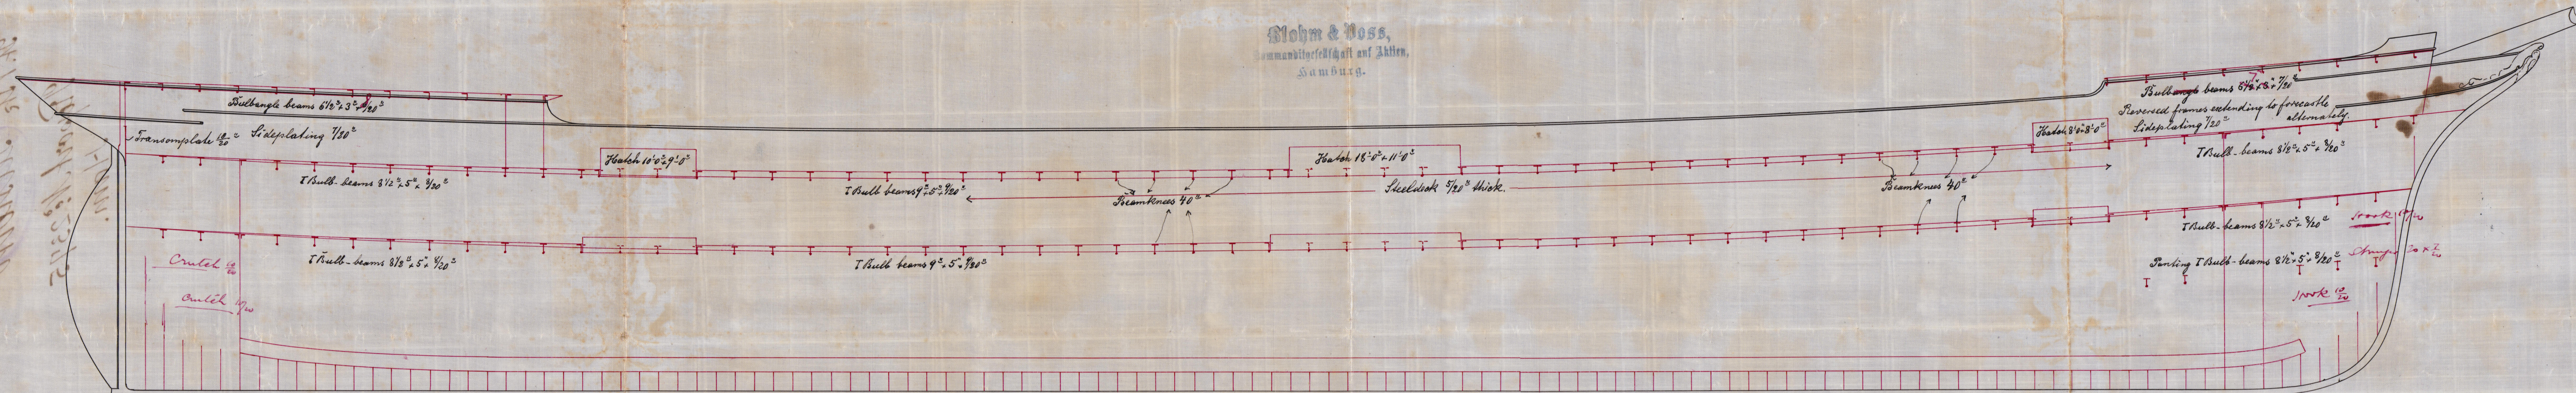

307/3/92

Sailing Ship No 92

Ham. 2nd / 3 92


Sp

Co

St. M. "Deestrum"

Report No 2375

Ham.

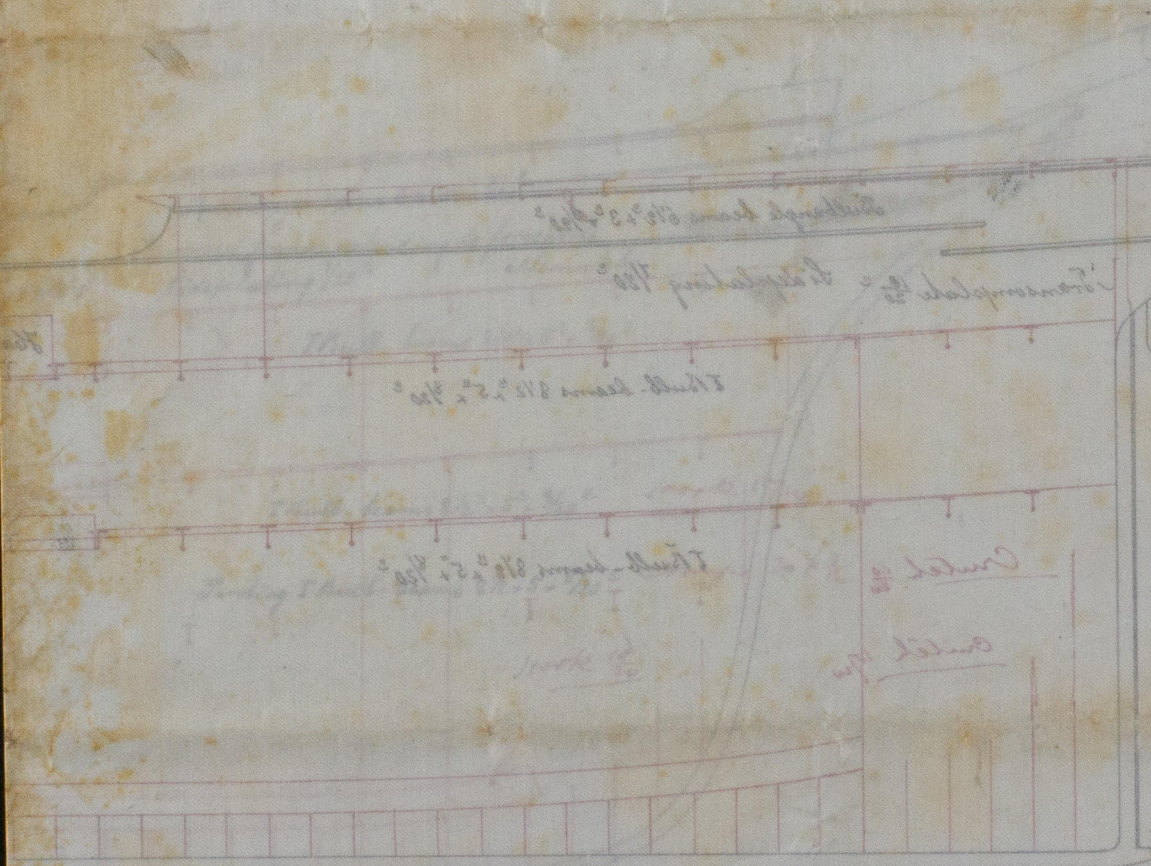

© 2020

Lloyd's Register
Foundation

HAM1118-0185