

# Lloyd's Register of British and Foreign Shipping.

*Hamburg*

(Report on Vessel No. *2504* Port *Hamburg*)

*S/S Irene*

*Hamburg*

No. *2376 a.*

## SHIP FORGINGS OR CASTINGS.

The words FORGINGS or CASTINGS, IRON or STEEL, should be struck out as may be required.

I have to report that the undermentioned Iron or ~~Steel~~ Forgings or Castings, manufactured by *The Darlington Forge Co.* of *Darlington* for the Vessel No. *387*, being built by *The Reicherting & B Co.* of *Hamburg* have been inspected by me as set forth below, and found to be, so far as can be seen, *sound.*

*There has to be a band fitted round the neck of the rudder below the counter as arranged when the drawing was submitted for the Committee approval*

Mark on Forgings.




Lloyd's  
No. *2376 a*  
*16. C.*

*Wm Cameron*

*London*  
*19. 12. 92*

	STERN FRAME.	RUDDER FRAME.	STEM.
Material* - - - -	<i>Scrap iron</i>	<i>Scrap iron</i>	
How made - - - -	<i>Faged</i>	<i>Faged</i>	
Dimensions - - - -	<i>11 1/2" x 6"</i>	<i>9" - 5"</i>	
Progress on Inspection -	<i>Faged &amp; smithed</i>	<i>Faged &amp; smithed</i>	
Dates when Inspected	<i>Aug 17<sup>th</sup> to Dec 7/92</i>	<i>Oct 7<sup>th</sup> to Dec 7/92</i>	

SKETCHES OF FRAMES SHEWING POSITION AND DESCRIPTION OF WELDS OF FORGINGS, OR PARTICULARS OF TESTS APPLIED TO CASTINGS.

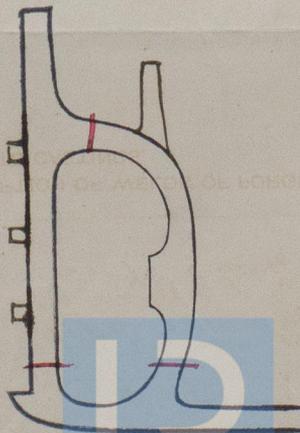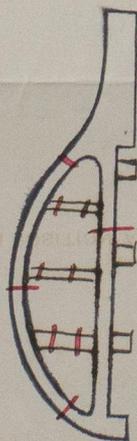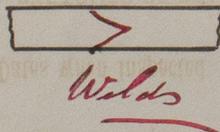

© 2020

Lloyd's Register Foundation

\* If of Iron, state whether scrap or puddled iron.