


Dr. 11-7-92


Project No 136.  
S. S. No 387.


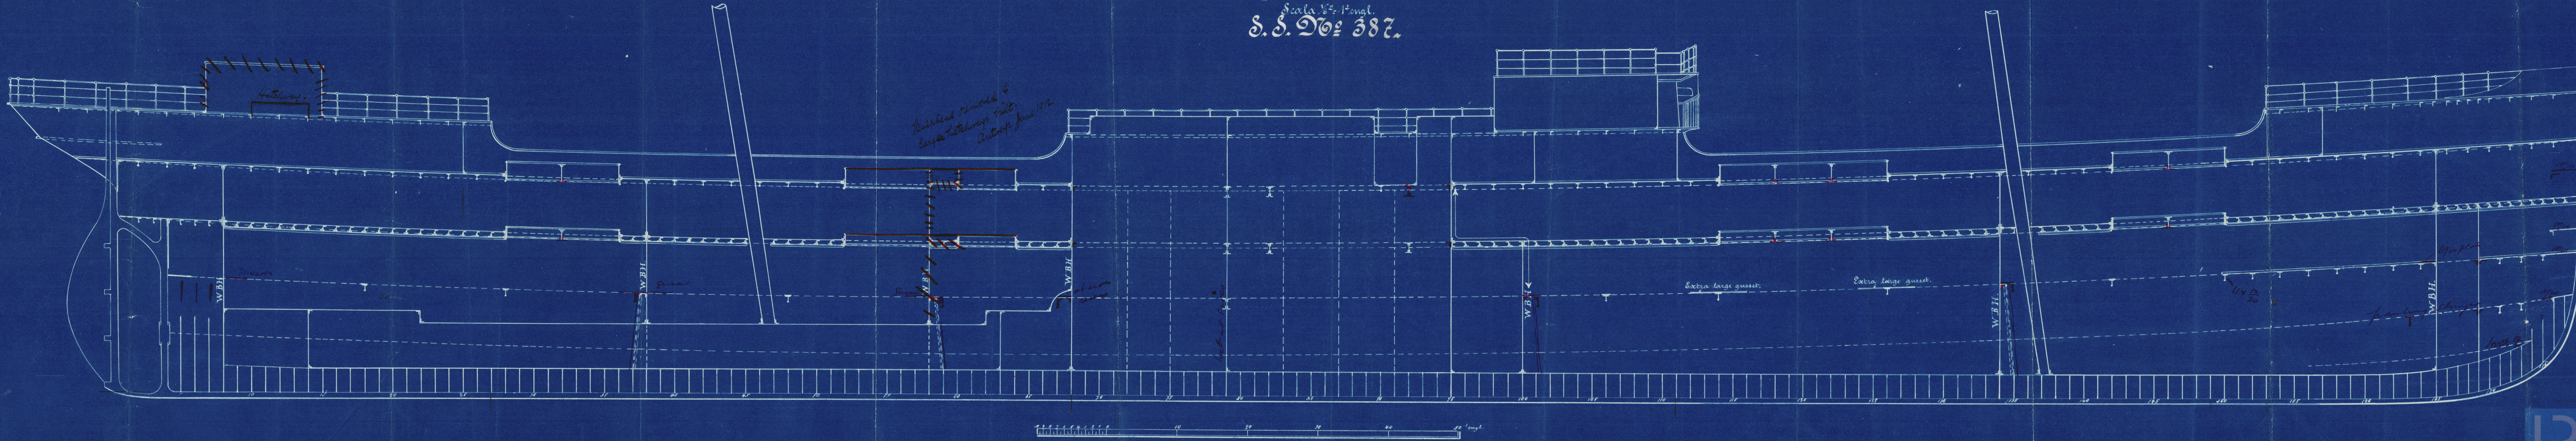

R

11AM 11-13-1913



S.S. No 387

to be built by  
the Reihorstieg  
Schiffw. & Masch.

Ham. letter 7/7 92

Stadl. & Irene

Report No 2504 Ham.

Profile.

---

Bulgaria  
ex Heidelberg  
ex Irene

---

REGISTERED  
SHIPPING  
AGENTS  
LLOYD'S REGISTER  
OF SHIPPING



© 2020

Lloyd's Register

Foundation 1825