


7.12.96

S.S. OCTAVIA

Longitudinal section S.S. No 170. - 1/2" = 1 ft.

See Corrected Longitudinal Plan

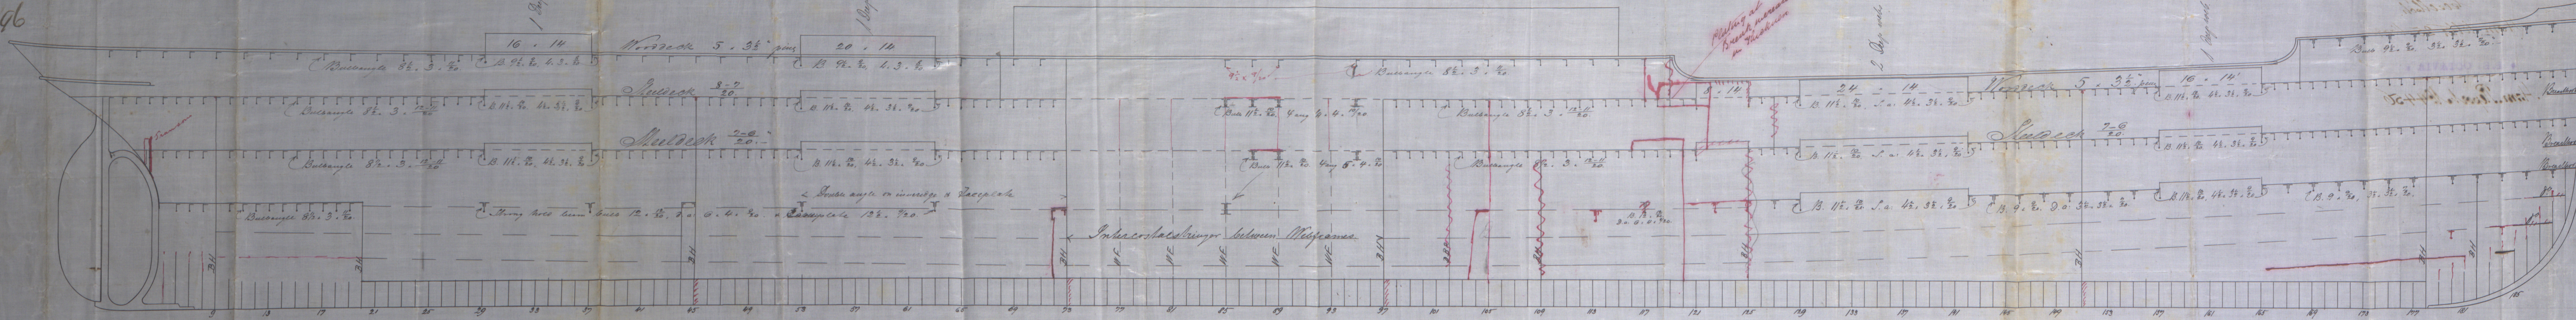

J.H.
7/12/96


Longitudinal
S/S No 170

to be built by the
Flensburger Schiffb.
werckh.

Ham letter 25 Nov 96

♦ S.S. OCTAVIA ♦

Ham. Report No 4456

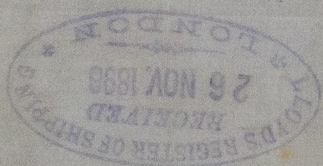

© 2019

Lloyd's Register
Foundation

HAM 1120-0054