
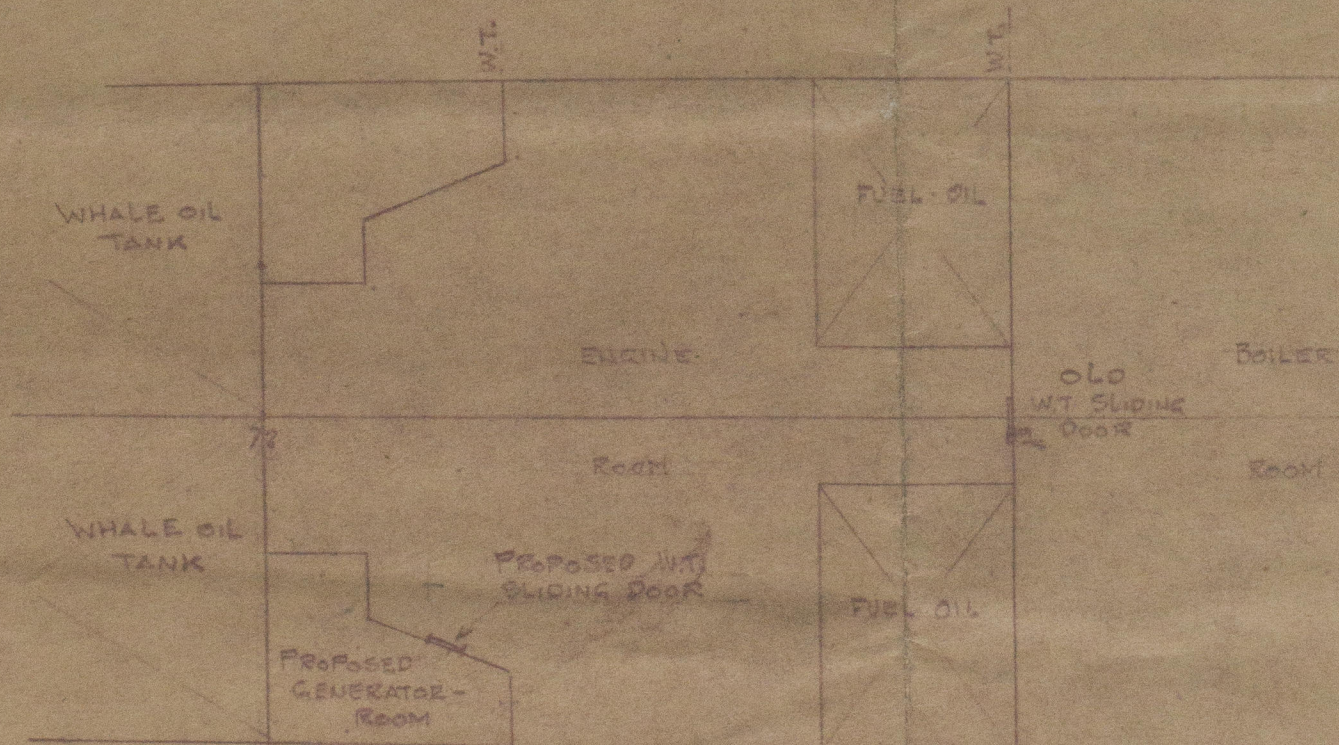


SECTION ON FR#74  
LOOKING AFT

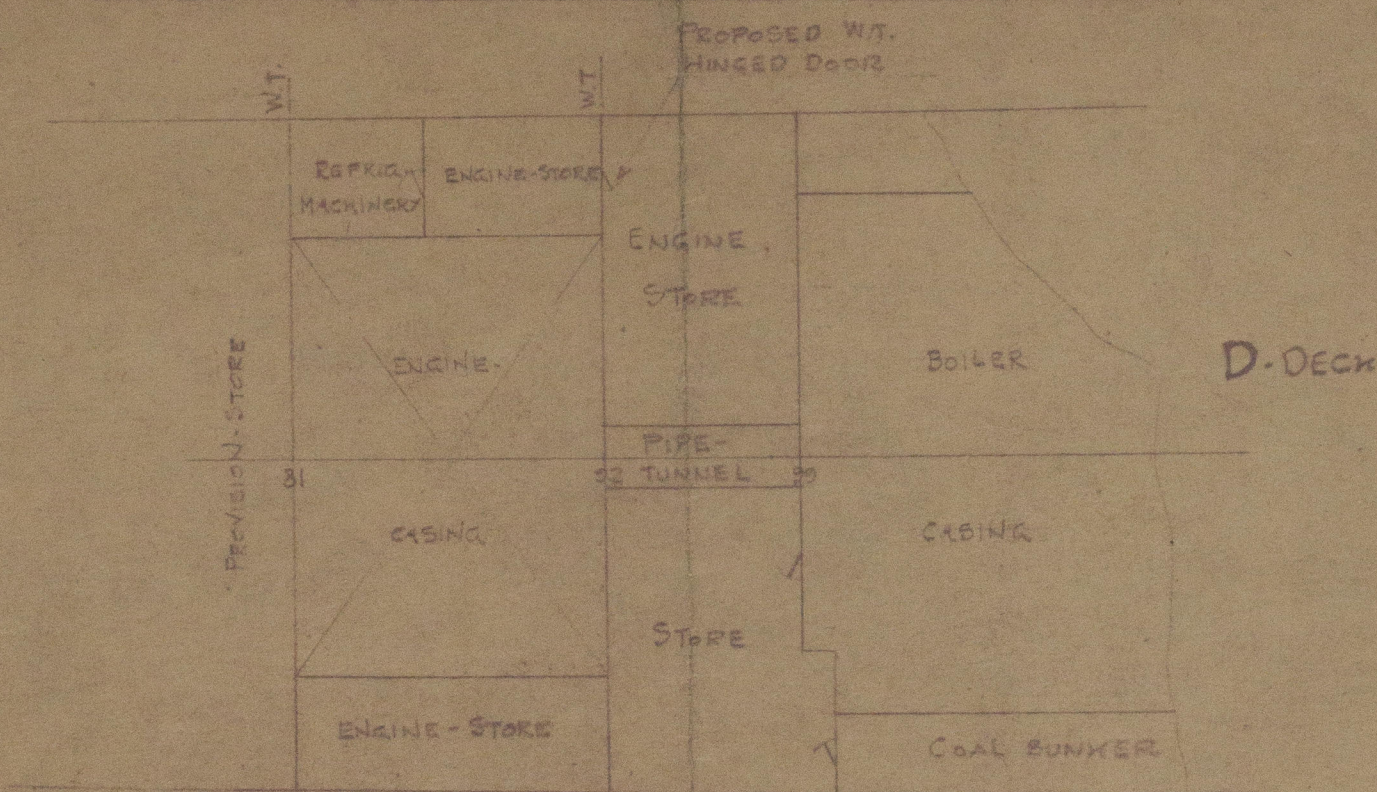

5/5 "SOLGLINT"

PROPOSED WT. DOORS IN  
ENGINE SPACE

SCALE 1/8" = 1'

W.S.  
18.6.29



© 2021 Lloyd's Register Foundation  
#60677