



Cancelled  
See later plan  
A.T.G.  
9-3-29.

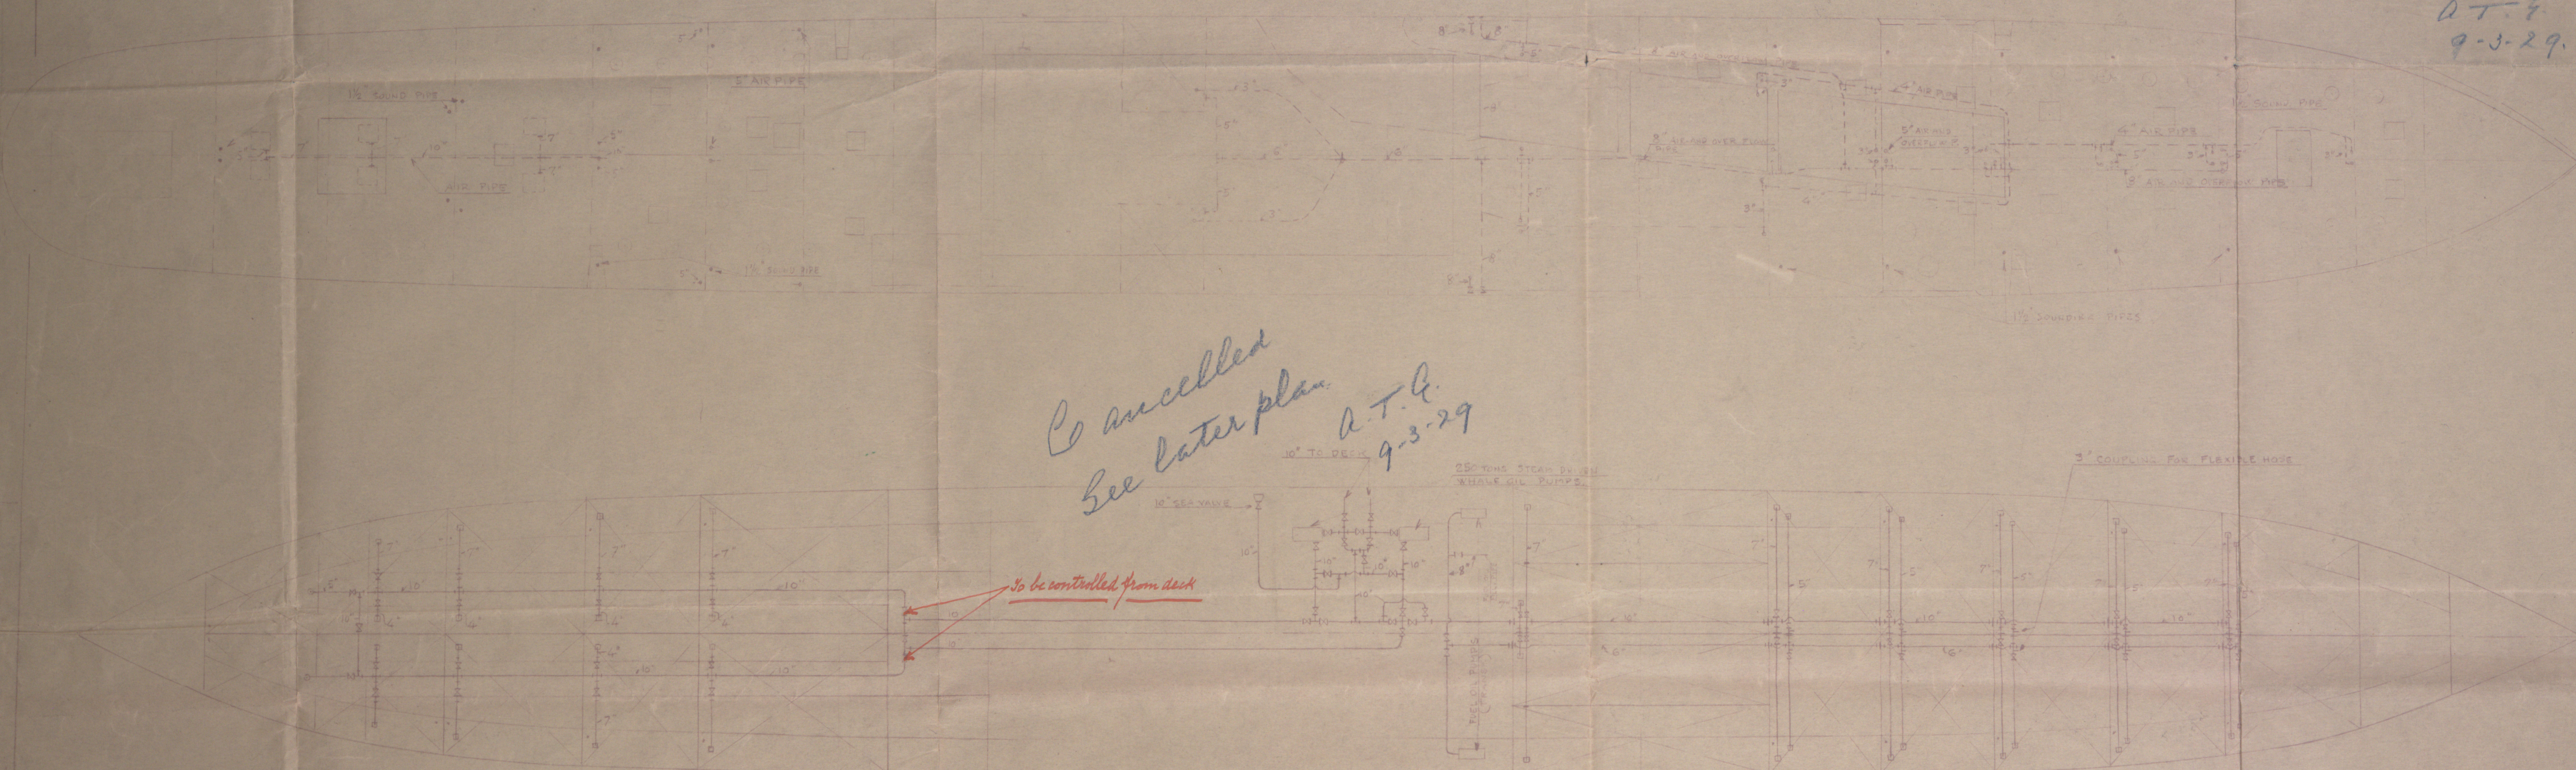

Cancelled  
See later plan  
A.T.G.  
9-3-29

*to be controlled from deck*

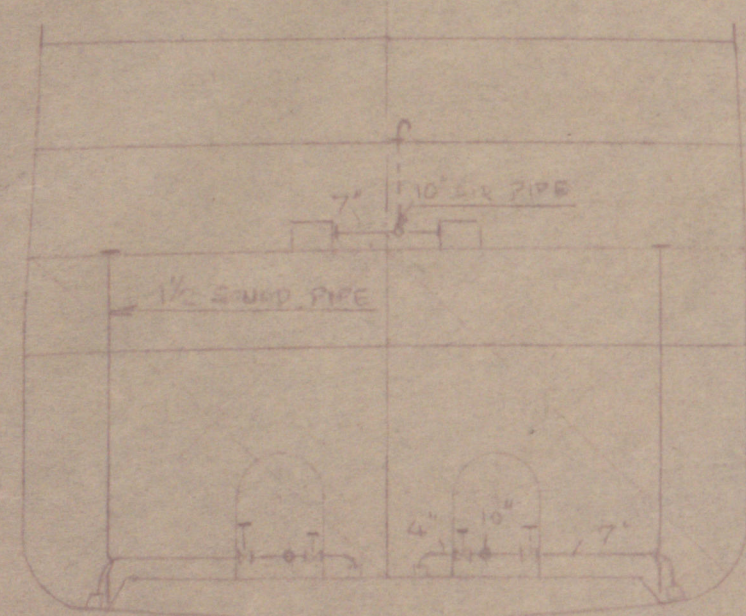

*Doubling plates, or their equivalent, to be fitted under all sounding pipes*

THE FLASH POINT OF THE OIL FUEL TO BE ABOVE 150°F AND THE REMAINING REQUIREMENTS OF SECTION 49 OF THE RULES TO BE COMPLIED WITH.

A.T.G.  
31-1-29



COMPARE OLD DRAWG # 42012

A.B. GÖTAVERKEN  
S. STOCKHOLM  
DRAWING ARRANGEMENT  
FOR DEEP TANKS

DRAWN BY: DATE: 12-1-29  
TRACED BY: DATE: 14-1-29  
CHECKED BY:



Lloyd's Register  
Foundation