



#60324

#60324

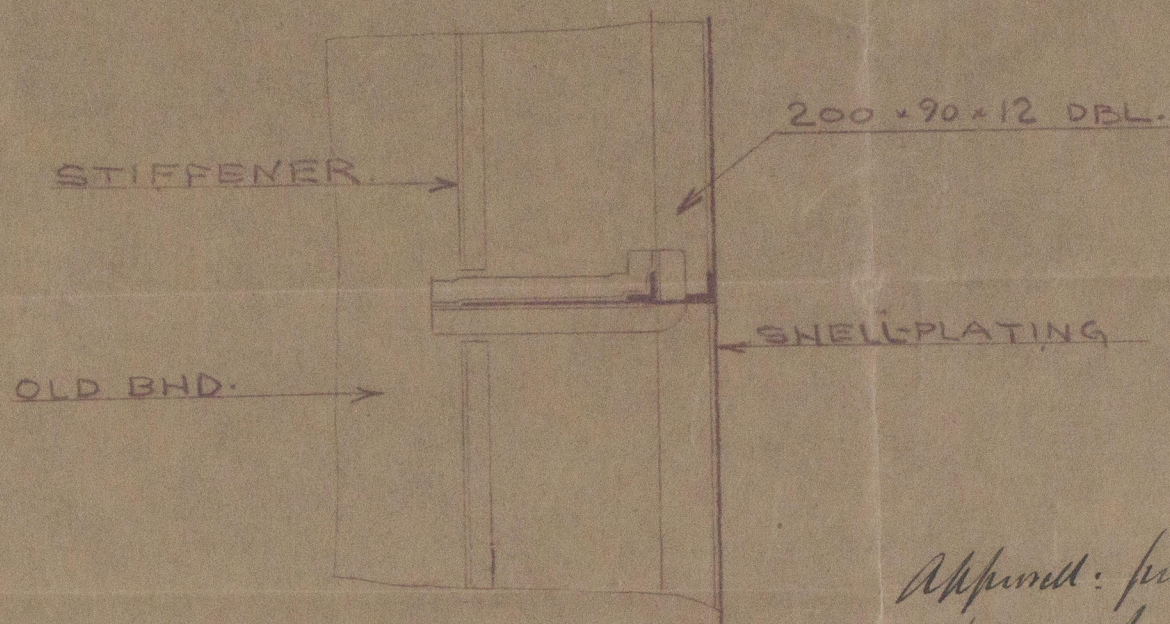


Office

Approved: provided additional web frame? ⁱⁿ Red on approved plan
pilot at present S.

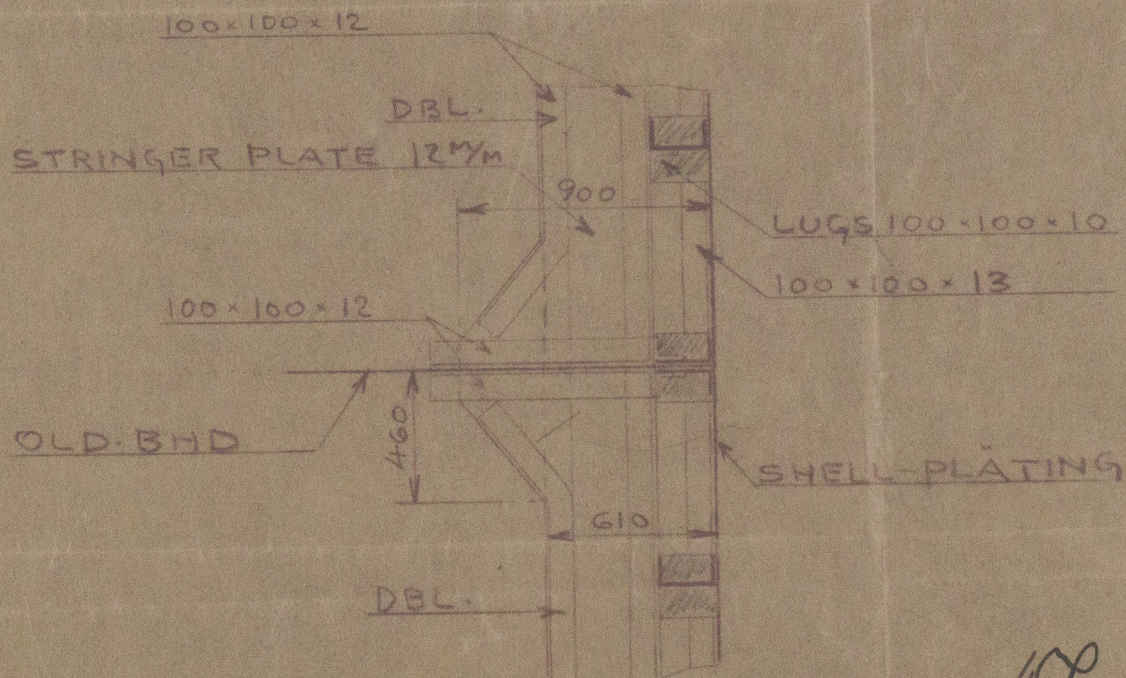

AS 15.4.29
S/S SOLGLINT
OLD ATTACHMENT FOR
STRINGER TO BULKHEAD

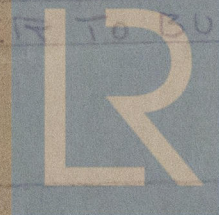

Lloyd's Register
Foundation

#60324

1122-0223

12 14 15
10
GEN BOX No



© 2021

Lloyd's Register
Foundation

1122-0223