


22065 #

101 102 103 104 105 106 107 108 109 110 111 112 113 114 115

#59877

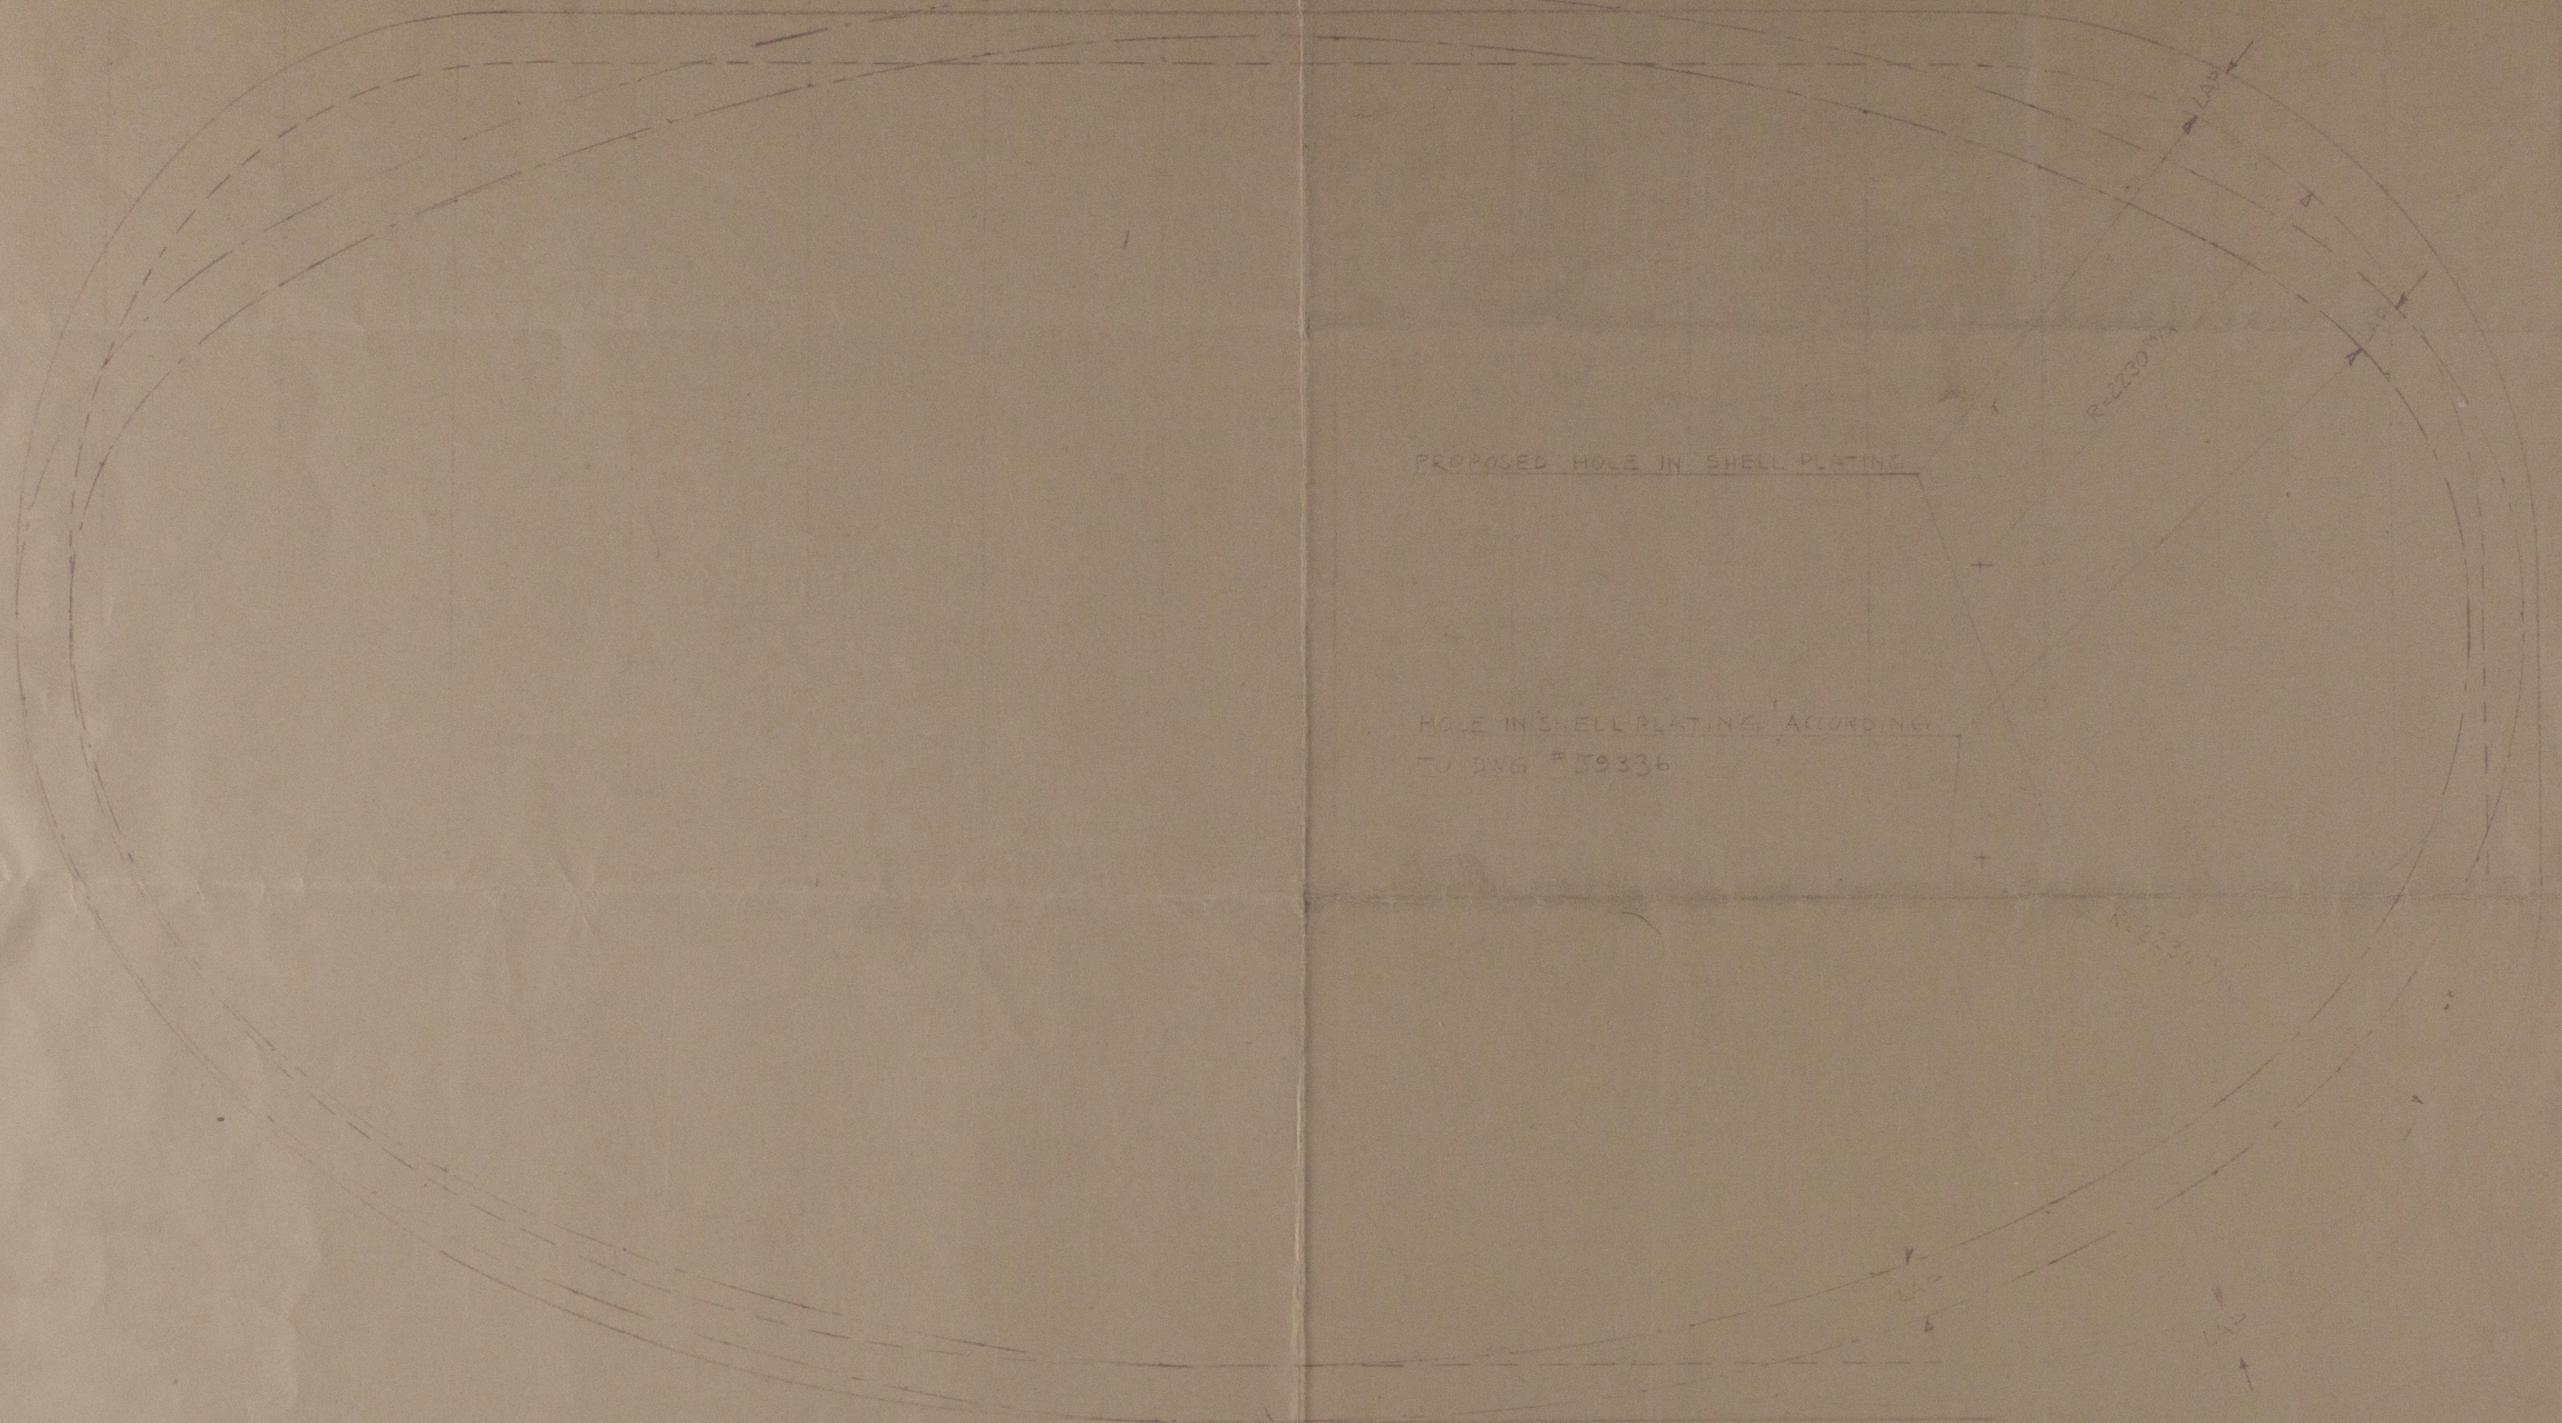

PROPOSED HOLE IN SHELL PLATING

HOLE IN SHELL PLATING ACCORDING TO DWG # 59336

R=2220 mm

R=2220 mm

*A.J.*

5.4.29



PROPOSED ALTERATION OF SHELL PLATING FOR WHARF DOCK



© 2021

Lloyd's Register Foundation

HAM1122-0229