

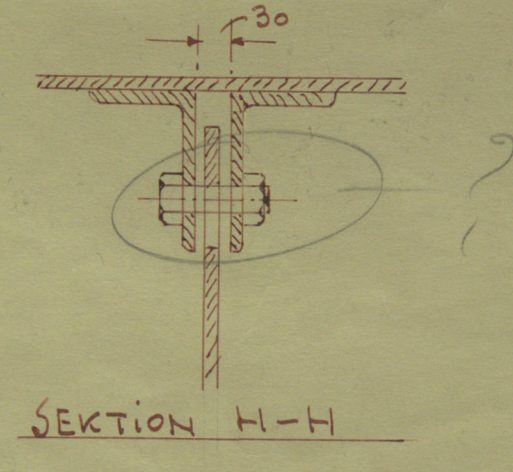
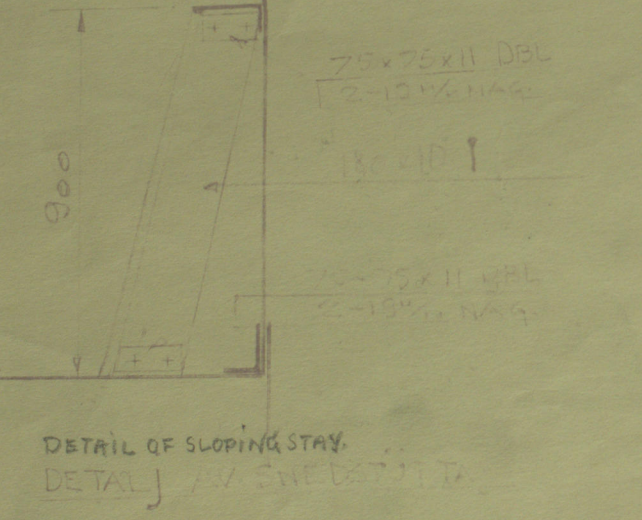
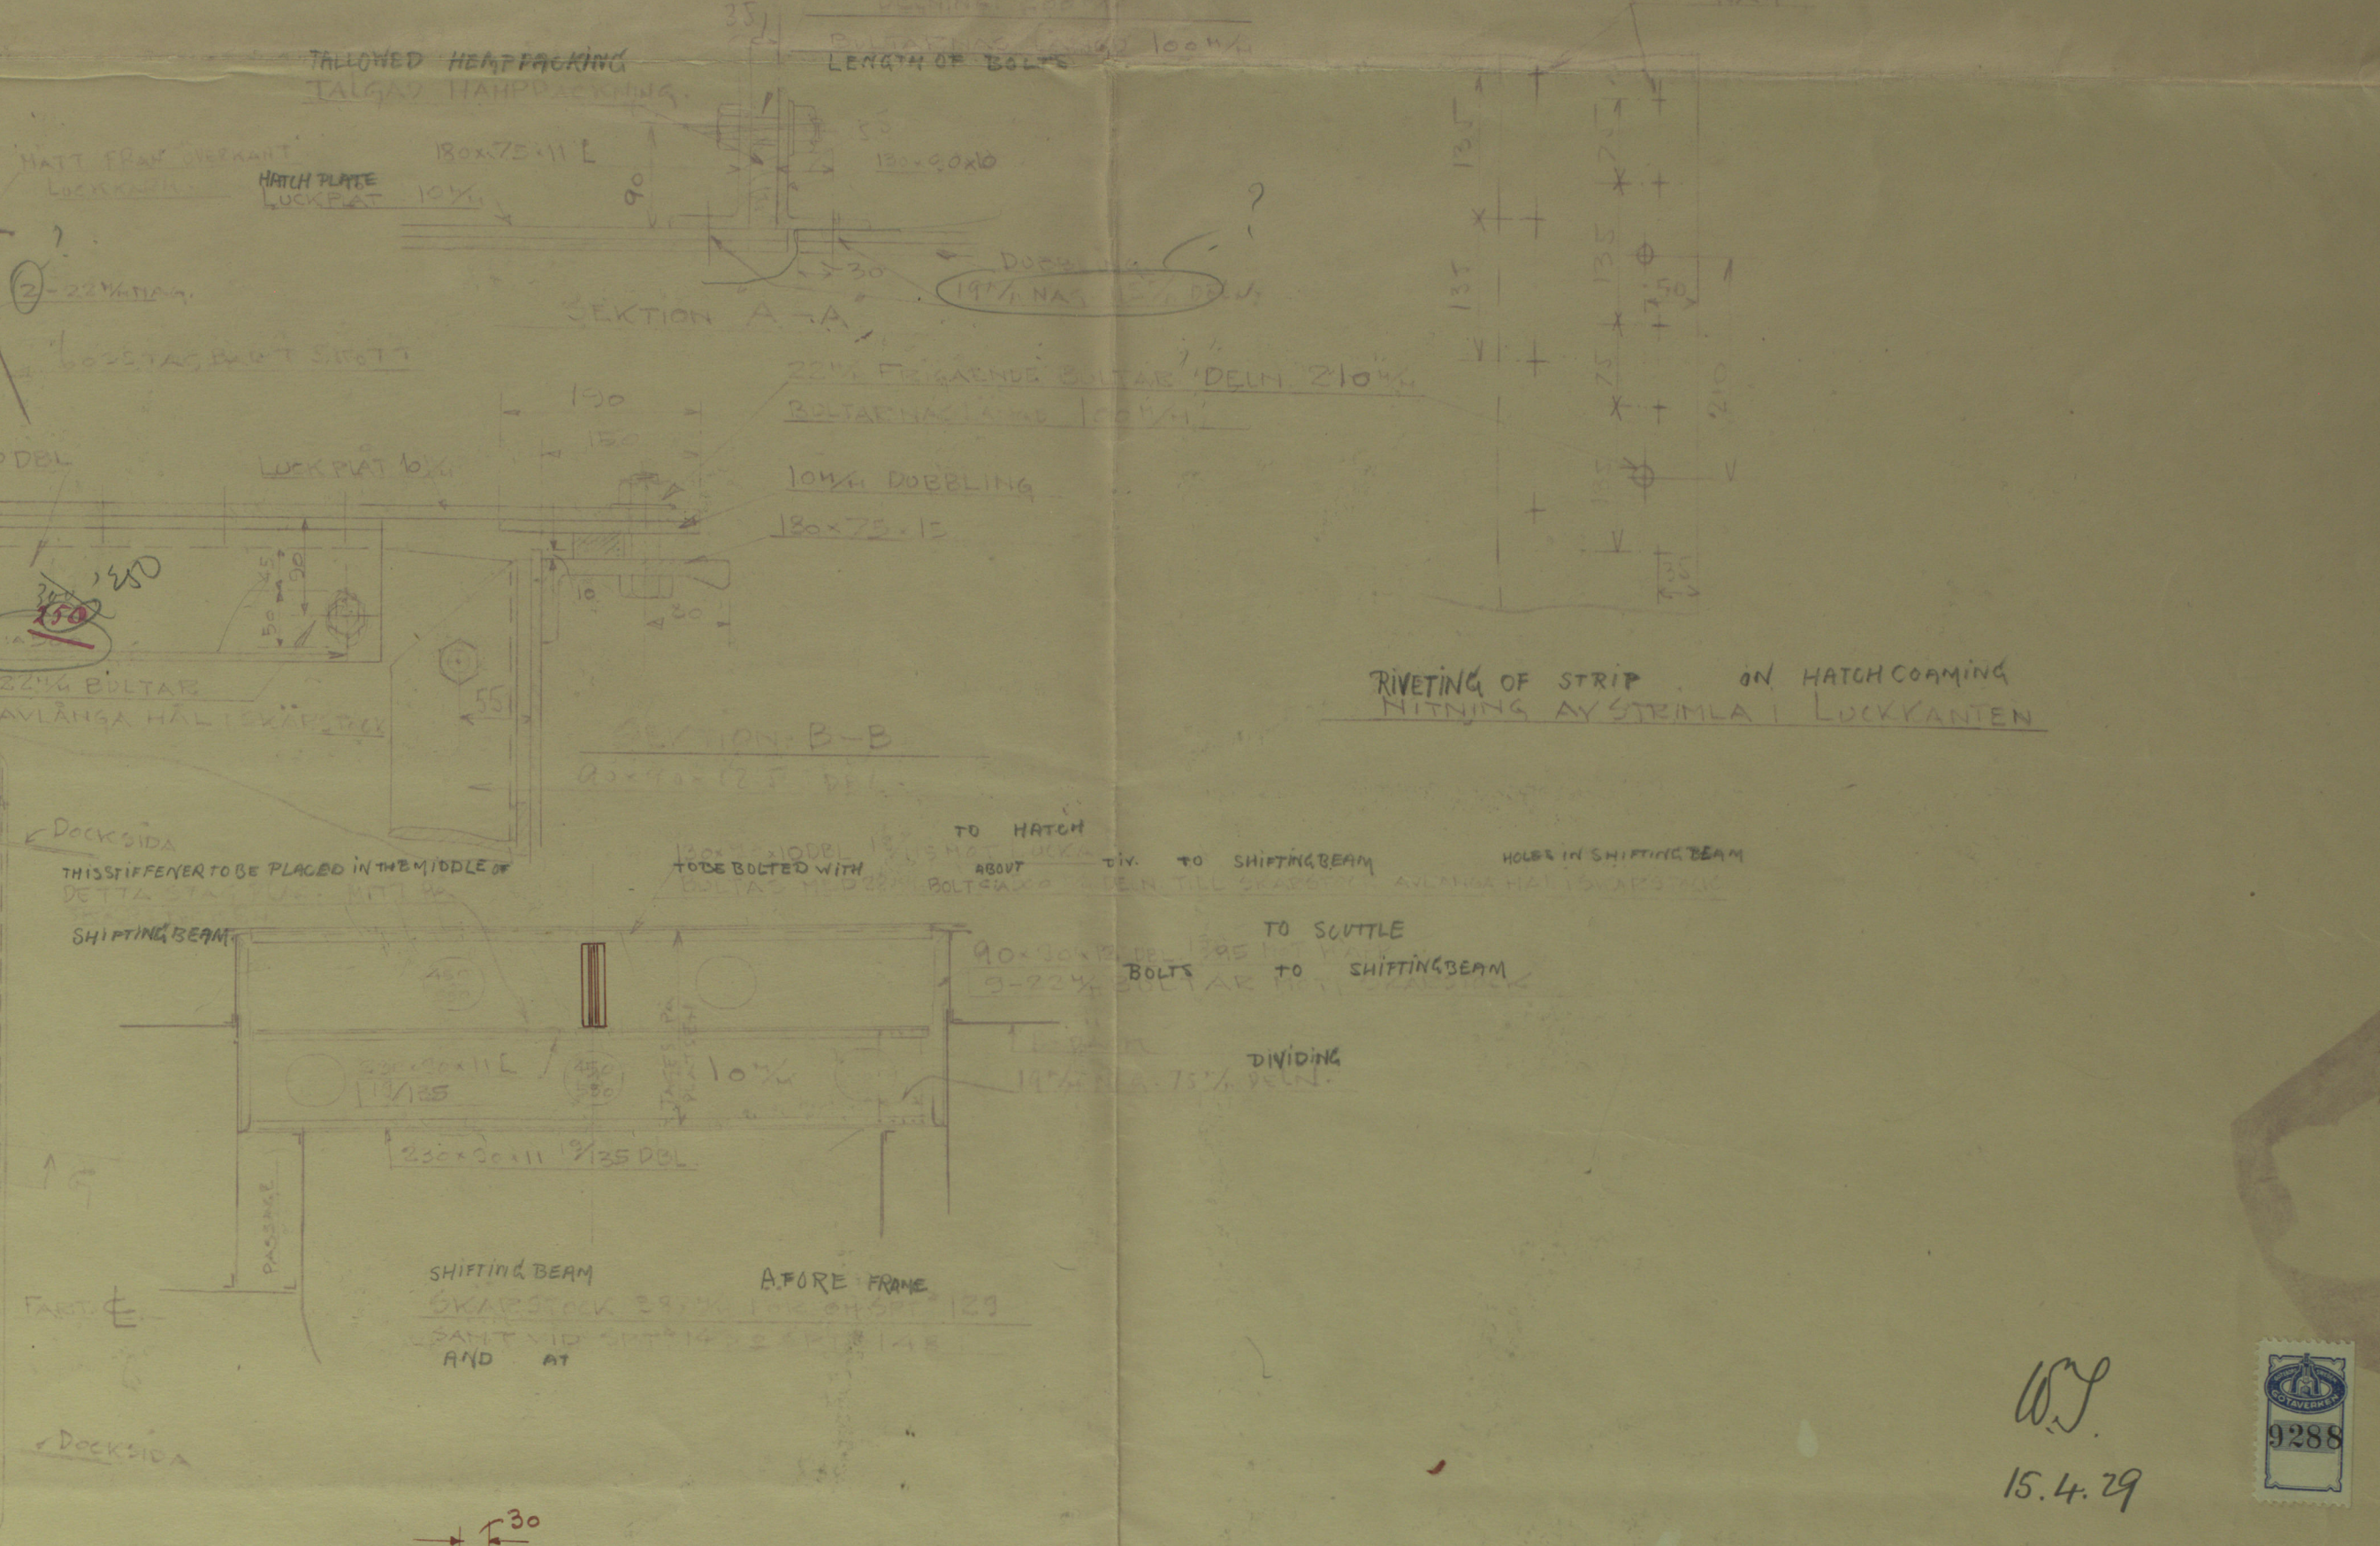
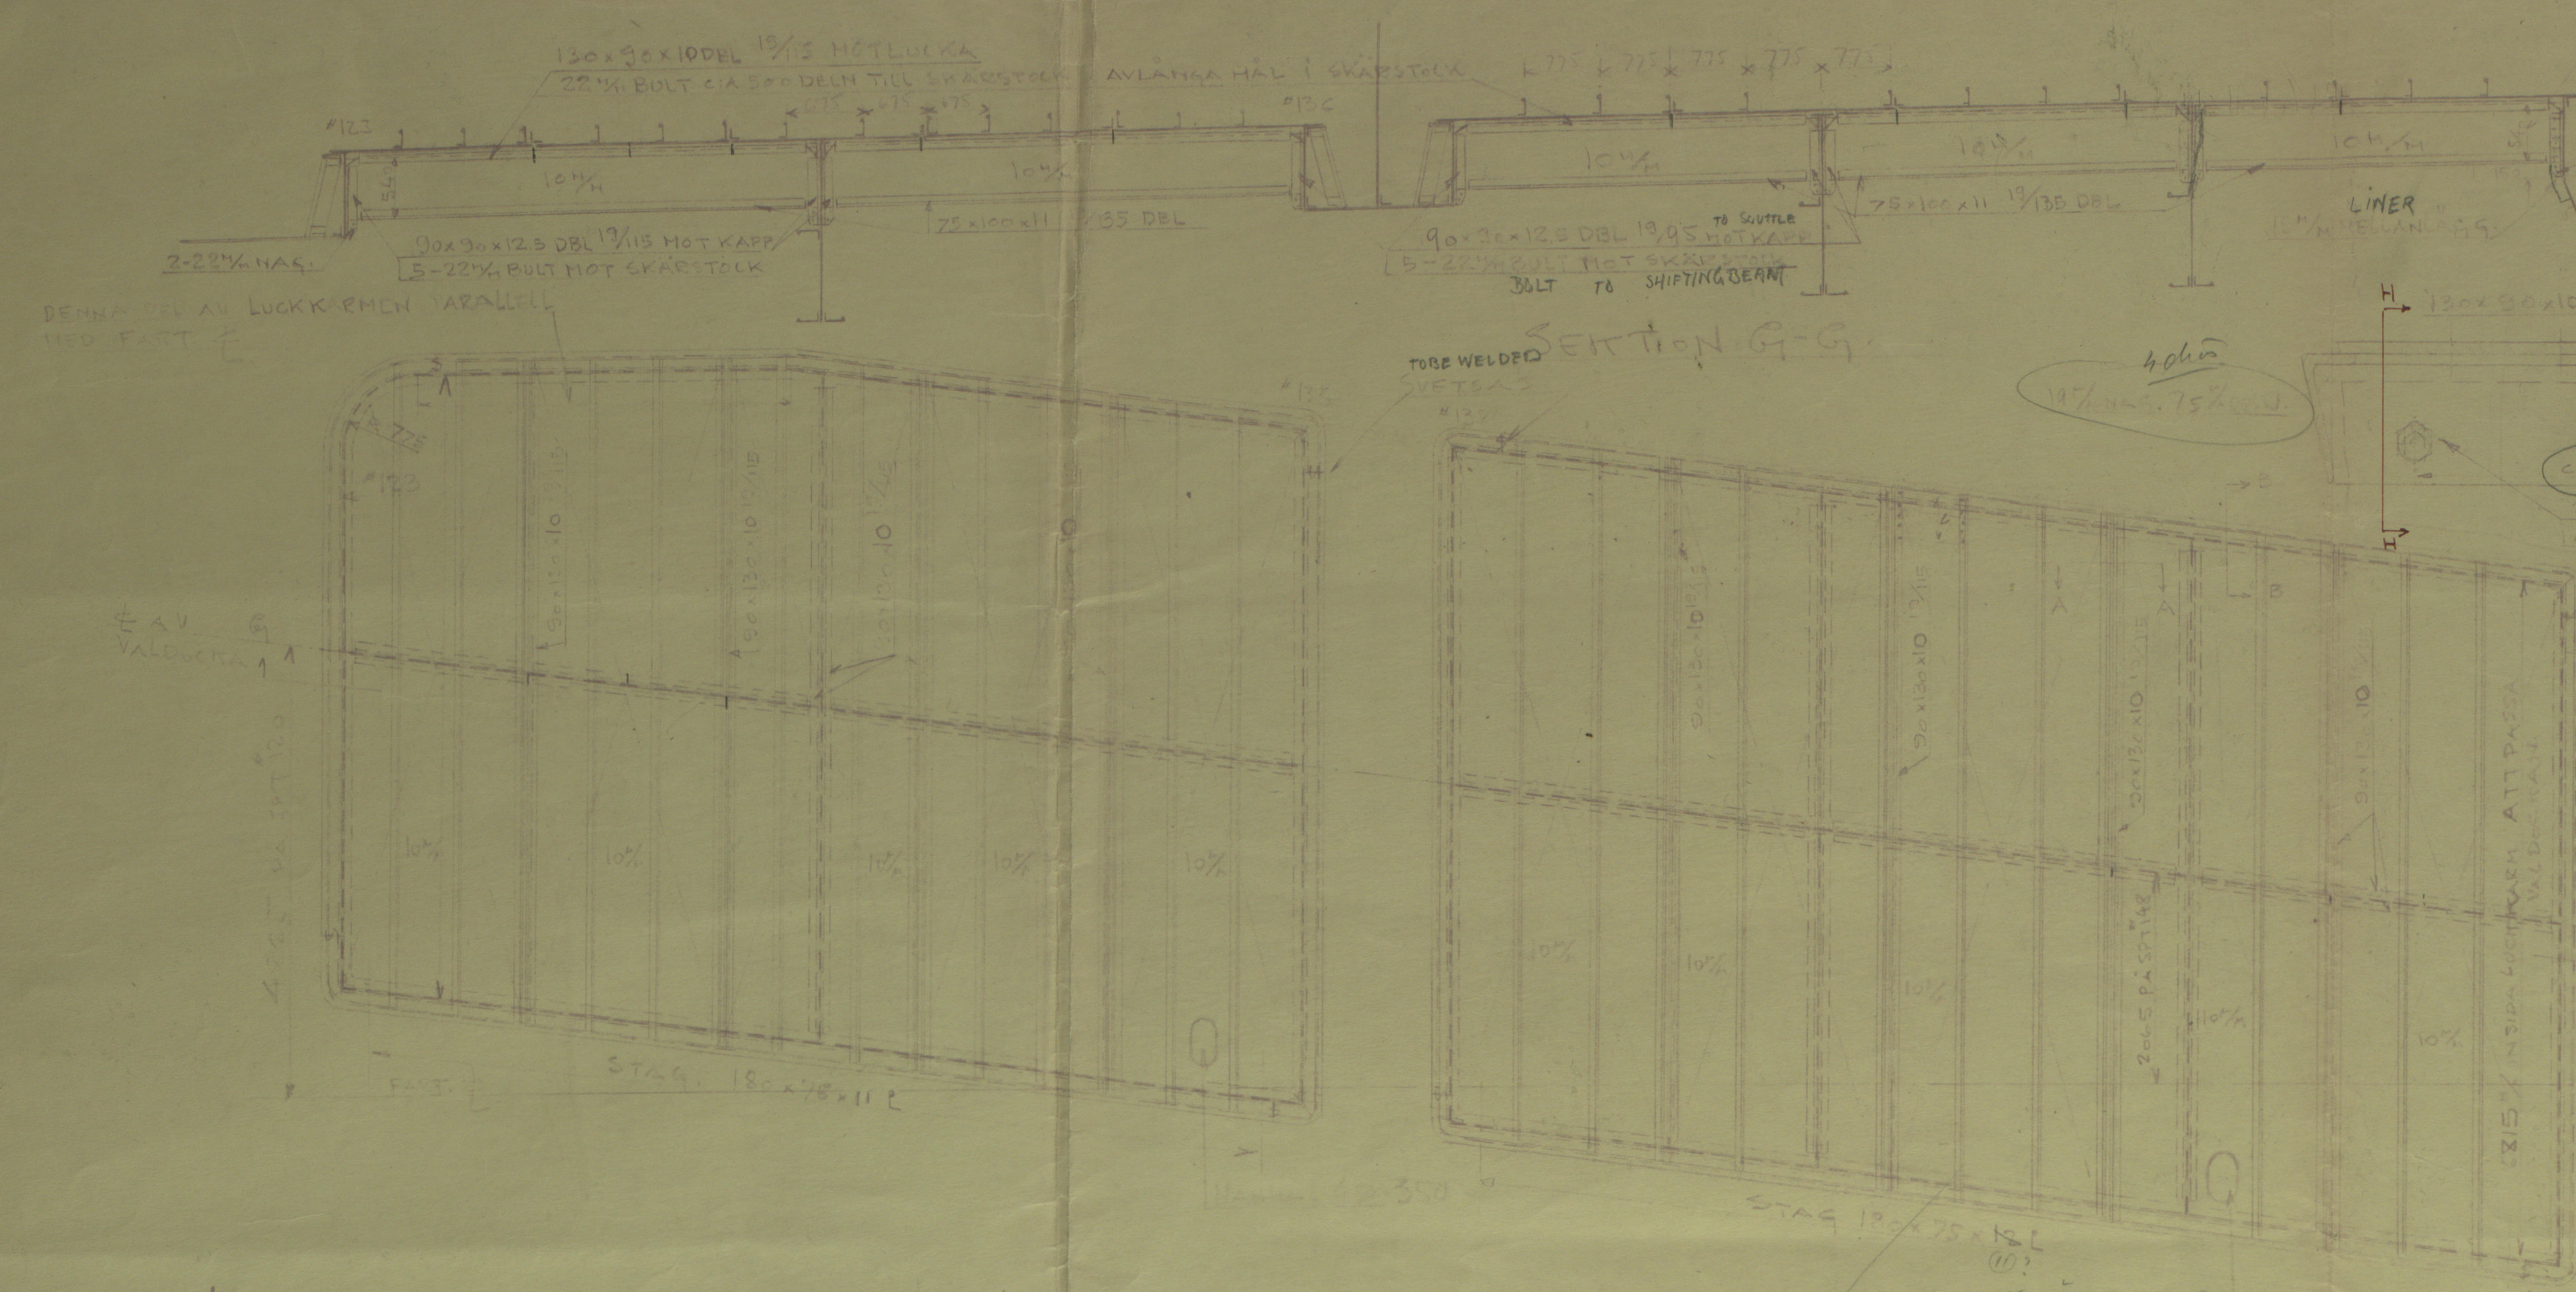


Office

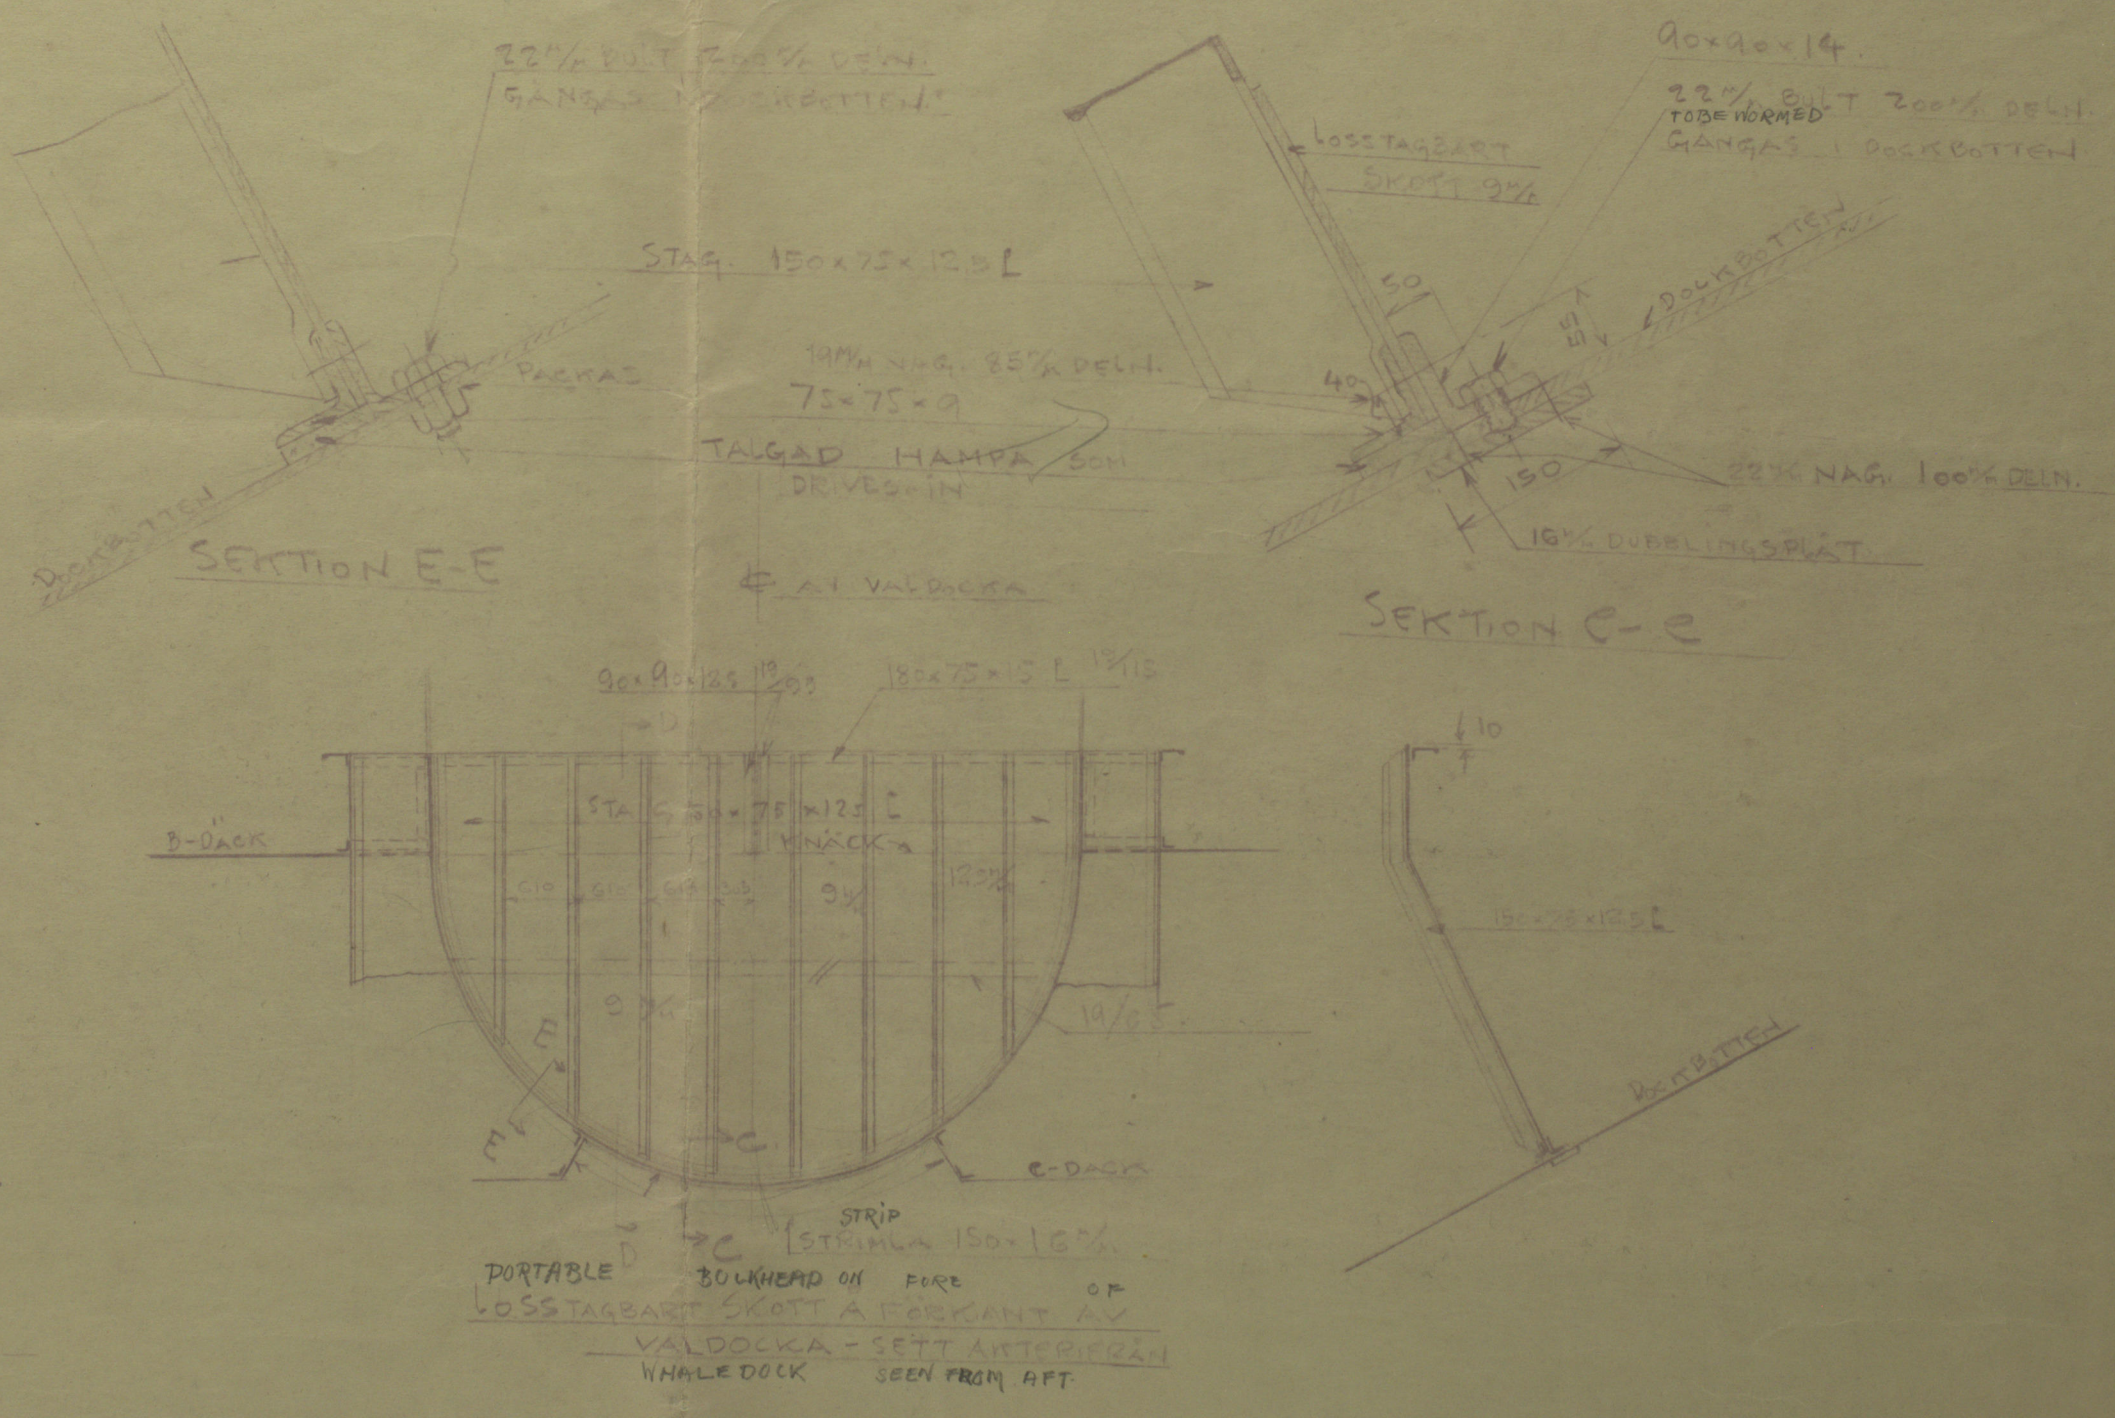

15.4.29

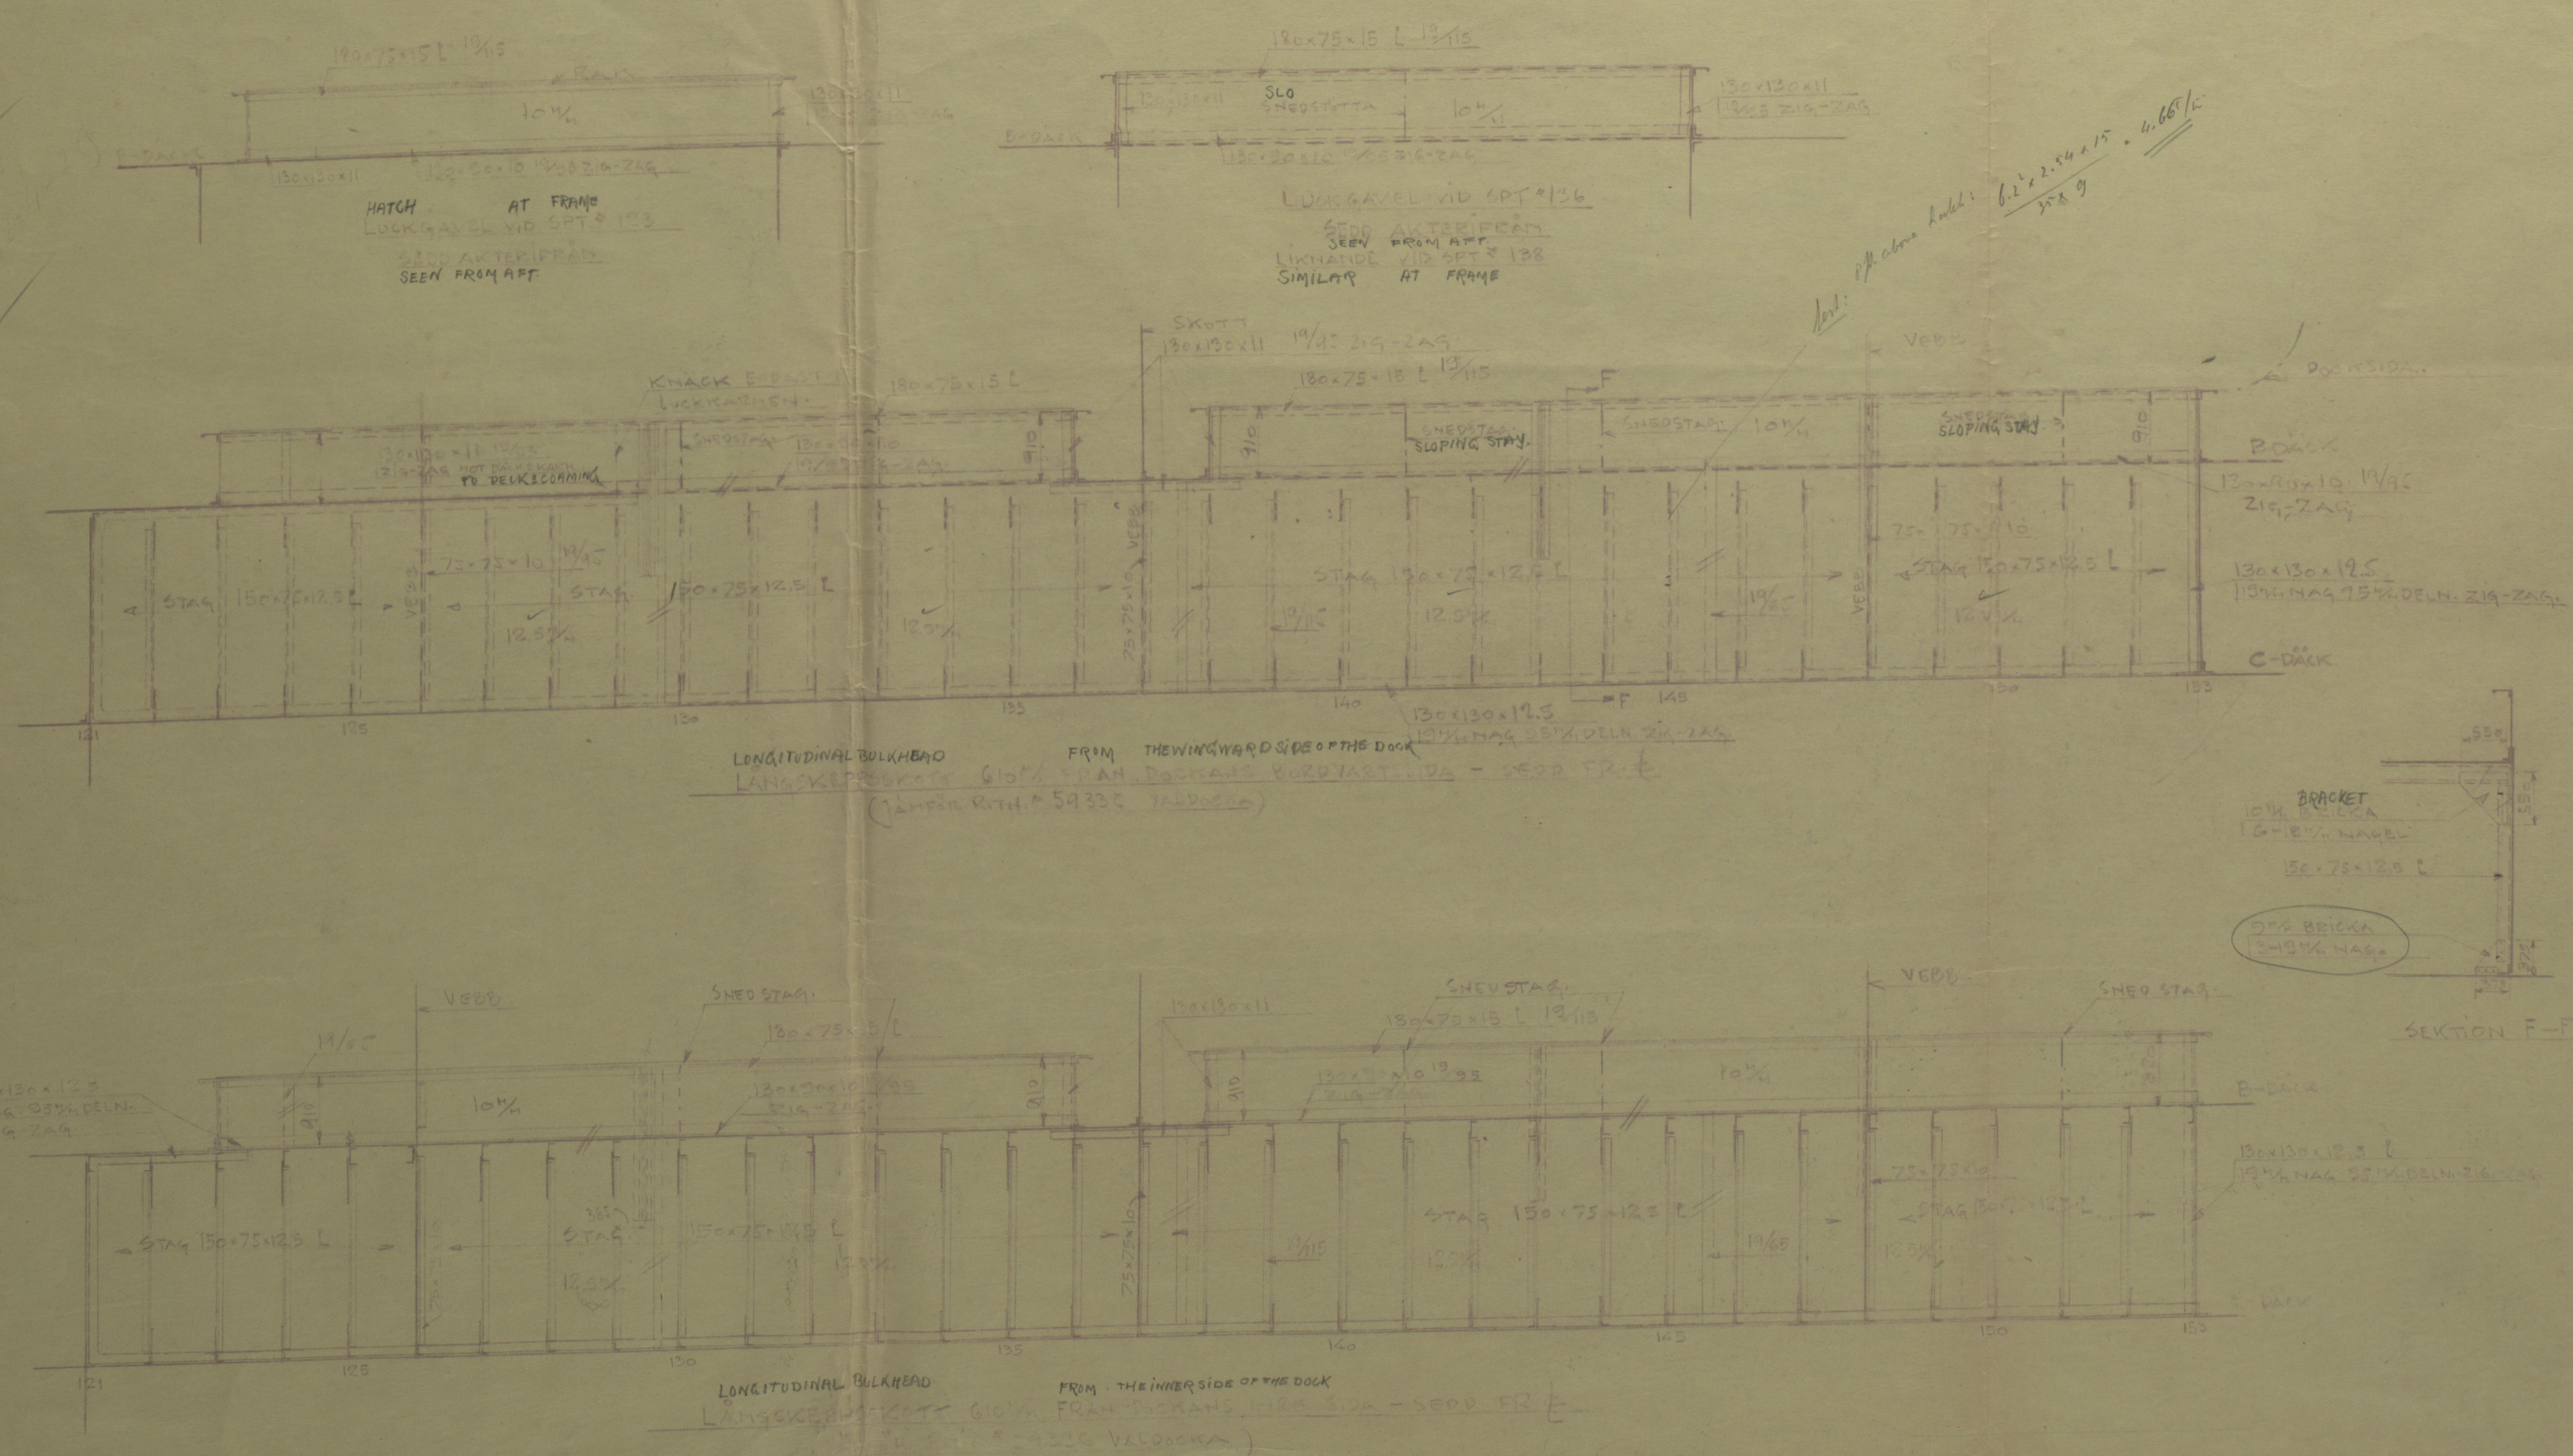


Translated.

Whale oil tight hatch in B: deck
for whale dock.

S/S "Solglint"

Aktiebolaget Gotaverken,
Gothenburg.

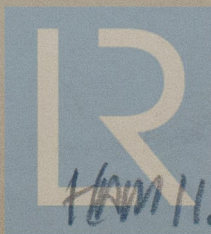

© 2019

Lloyd's Register
Foundation

HM 1122A

-0014