
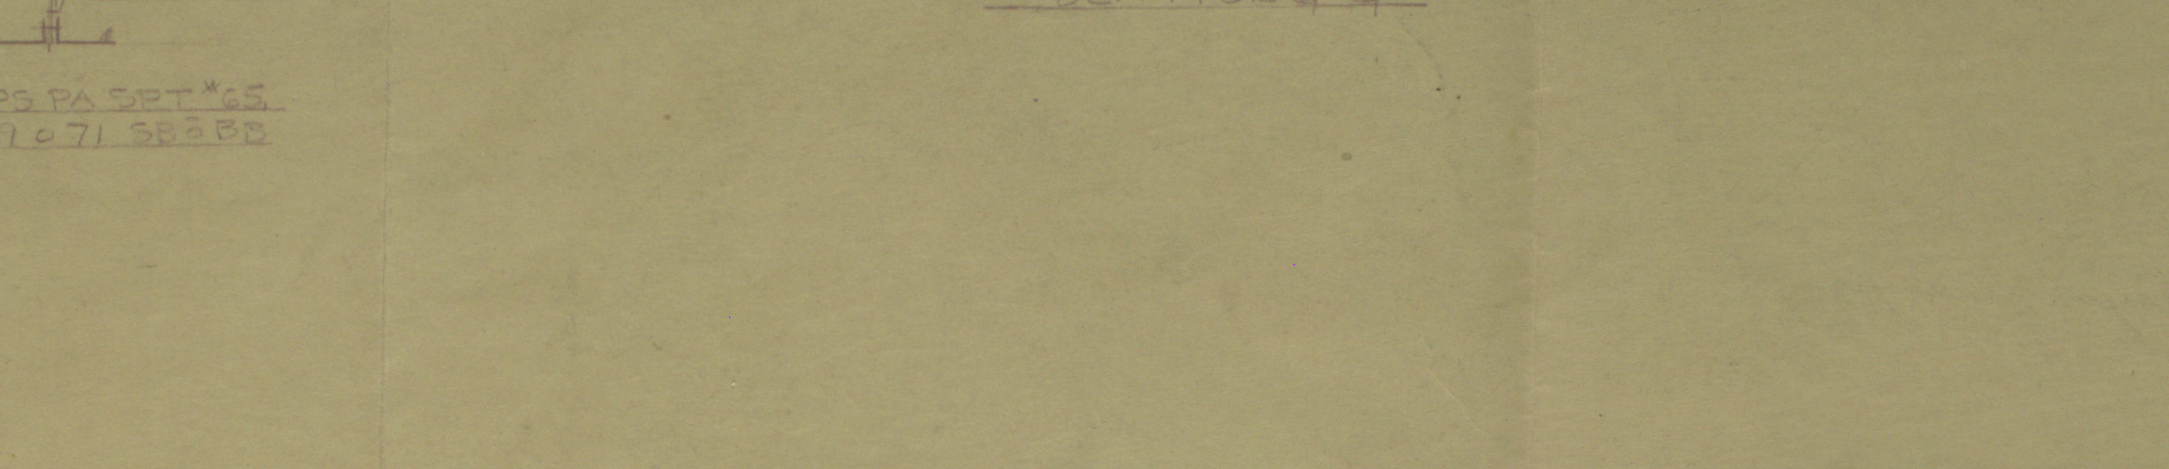
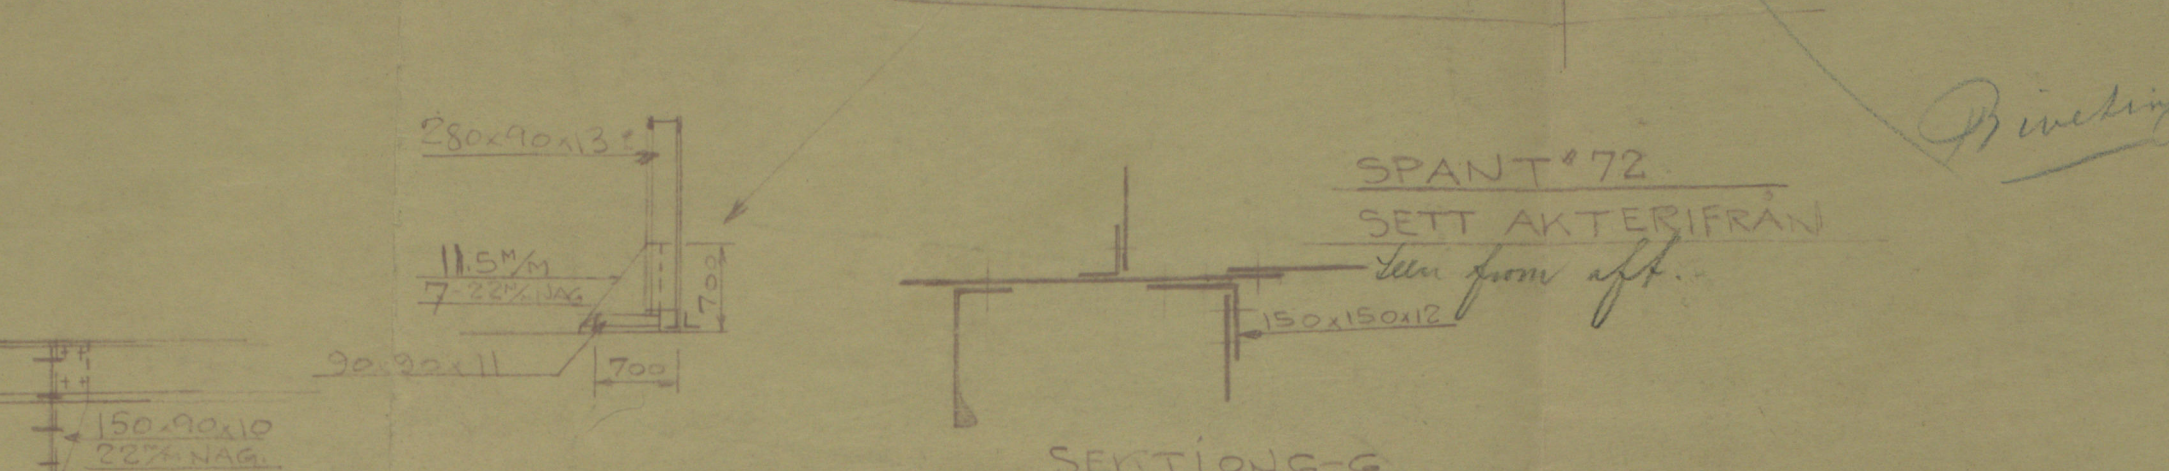
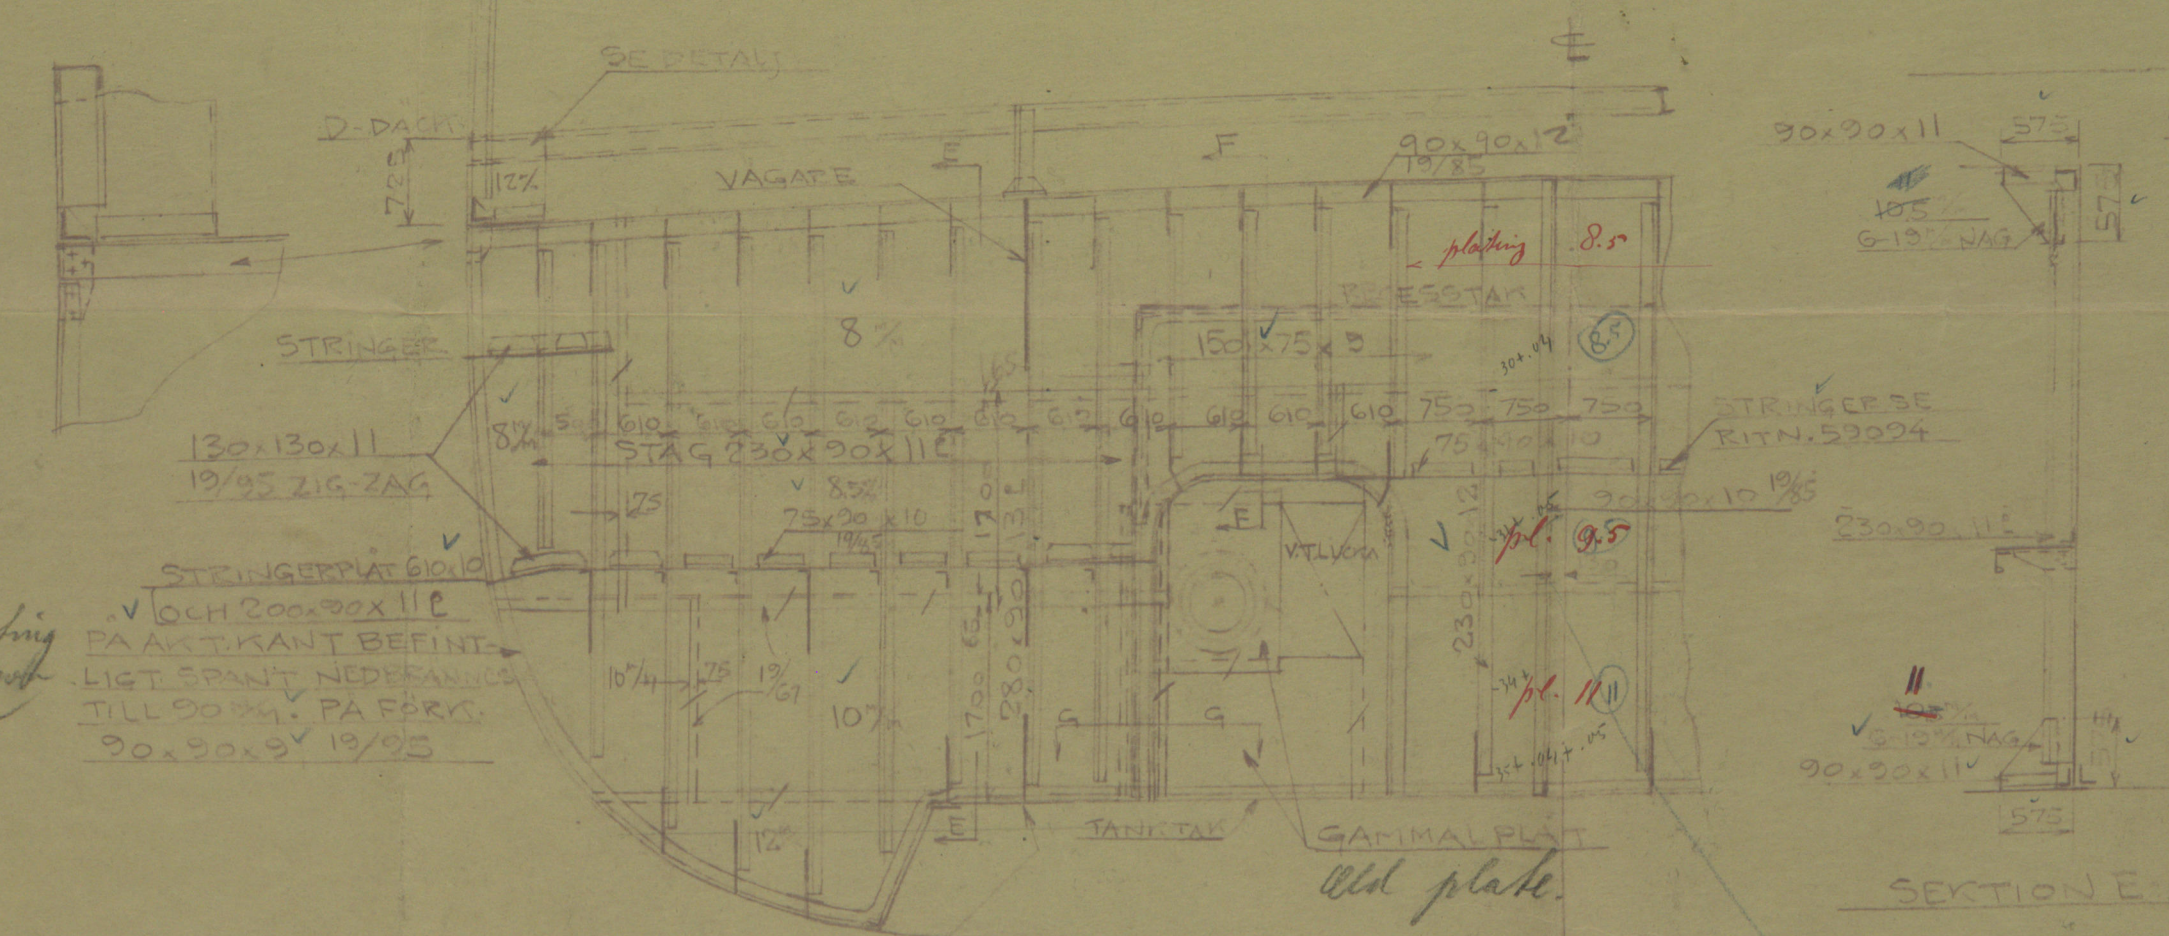


SEKTION B-B

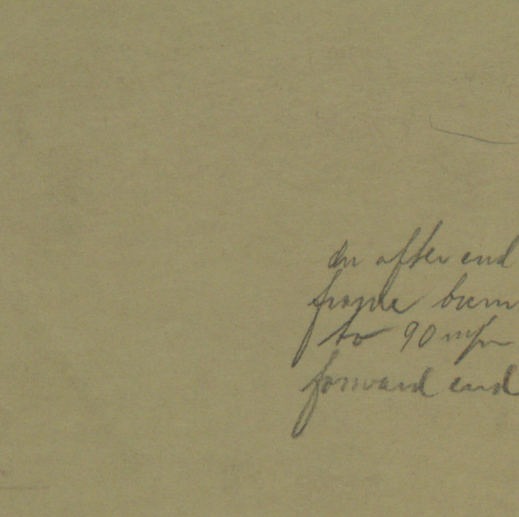

Distans markerad
NITNING MARKERAD
ALLA BULBYNAR ARO NB30A 1924
ELLER NY TYSK STANDARD 1927
or New German Standard

18.2.29

AKTIEBOLAGET GÖTAVERKEN			
S/S SOLGLIMT			
SKOTT PÅ SPT. 64 & 72			
SANT TANKTAK SPT 64-72			
HÅLL 1122 A - 8022			

(Transcribed.)

Bulkheads on frames 64 & 72.

S/S "Solglint" & "Stockholm".



© 2019

Lloyd's Register
Foundation

HAM1122A - 0022