


3/2 INCH TO ONE FOOT.

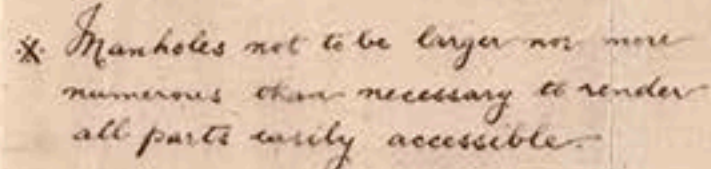

Φ SHELL BUT STRAPS $\frac{3}{30}$ THICKER } TREBLE FOR $\frac{1}{2}$ LENGTH
" $\frac{2}{40}$ " " DOUBLE T ENDS.

OUTSIDE PLATING ABOVE 40 INCHES BUT NOT EXCEEDING 46 IN WIDTH
INSIDE " OF 48 " " " " " 54 " "
BUTTS TO BE FULLY WELDED TO THE PLATE IN
ADDITION TO REQUIREMENTS IN CIRCULAR 552.

T. Turnbull & Son

Whitby

No 114 Vessel

Sketch of Midship
Section

S.S. "Fairmead"

W. H. Report No. 7980.



© 2018

Lloyd's Register
Foundation

HPL362/56