

S.S. "Fairmead"

Received at *W Hartlepool* Office *26th February 1890*

Lloyd's Register of British and Foreign Shipping.

W pool

(Report on Vessel No. *7980* Port *W Hartlepool*)

No. *1394.9*

SHIP FORGINGS OR CASTINGS.

I have to report that the undermentioned Iron or ~~Steel~~ Forgings or Castings, manufactured by *Mr Tho Ray* of *Gallion* for the Vessel No. *114*, being built by *Messrs J Turnbull Sons* of *Whitby* have been inspected by me as set forth below, and found to be, so far as can be seen, *sound*.


Mark on Forgings.

Lloyd's
No. *1394.9*
W.C.

Wm Harrison
Sunderland

	STERN FRAME.	RUDDER FRAME.	STEM.
Material*	<i>Scrap iron</i>	<i>Scrap iron</i>	
How made	<i>Forged</i>	<i>Forged</i>	
Dimensions	<i>10" x 6"</i>	<i>7 3/4" x 3 3/4"</i>	
Progress on Inspection .	<i>Forged & Smithed</i>	<i>Forged & Smithed</i>	<i>Not seen</i>
Dates when Inspected	<i>Oct 30 Nov 6-9-13-19-27</i> <i>Dec 5-7-13-18-19/89</i>	<i>Jan 8-11-16-20-29</i> <i>Feb 6-8-15/90</i>	

SKETCHES OF FRAMES SHEWING POSITION AND DESCRIPTION OF WELDS OF FORGINGS, OR PARTICULARS OF TESTS APPLIED TO CASTINGS.

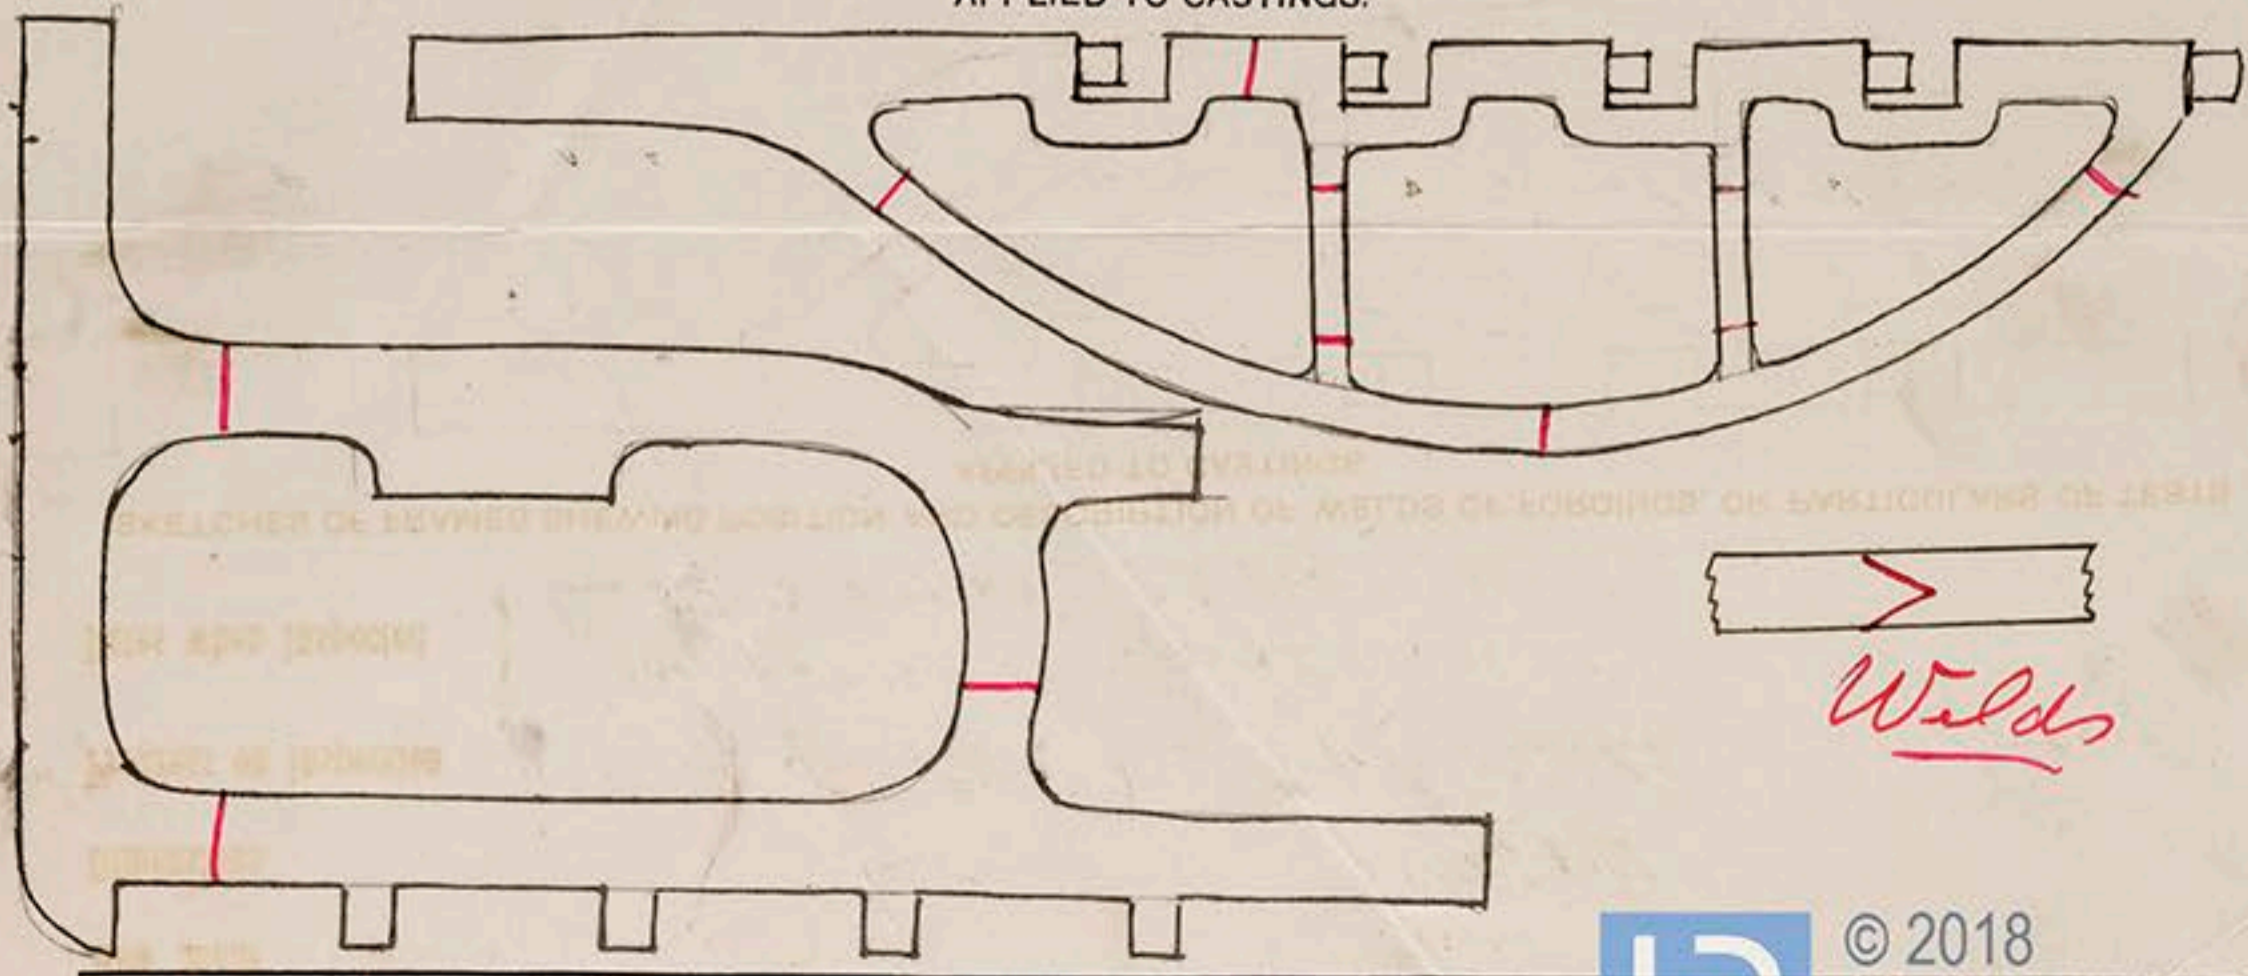

* If of Iron, state whether scrap or puddled Iron.

