


1/2 INCH TO ONE FOOT

Nekungali

604pl-8050

Copy

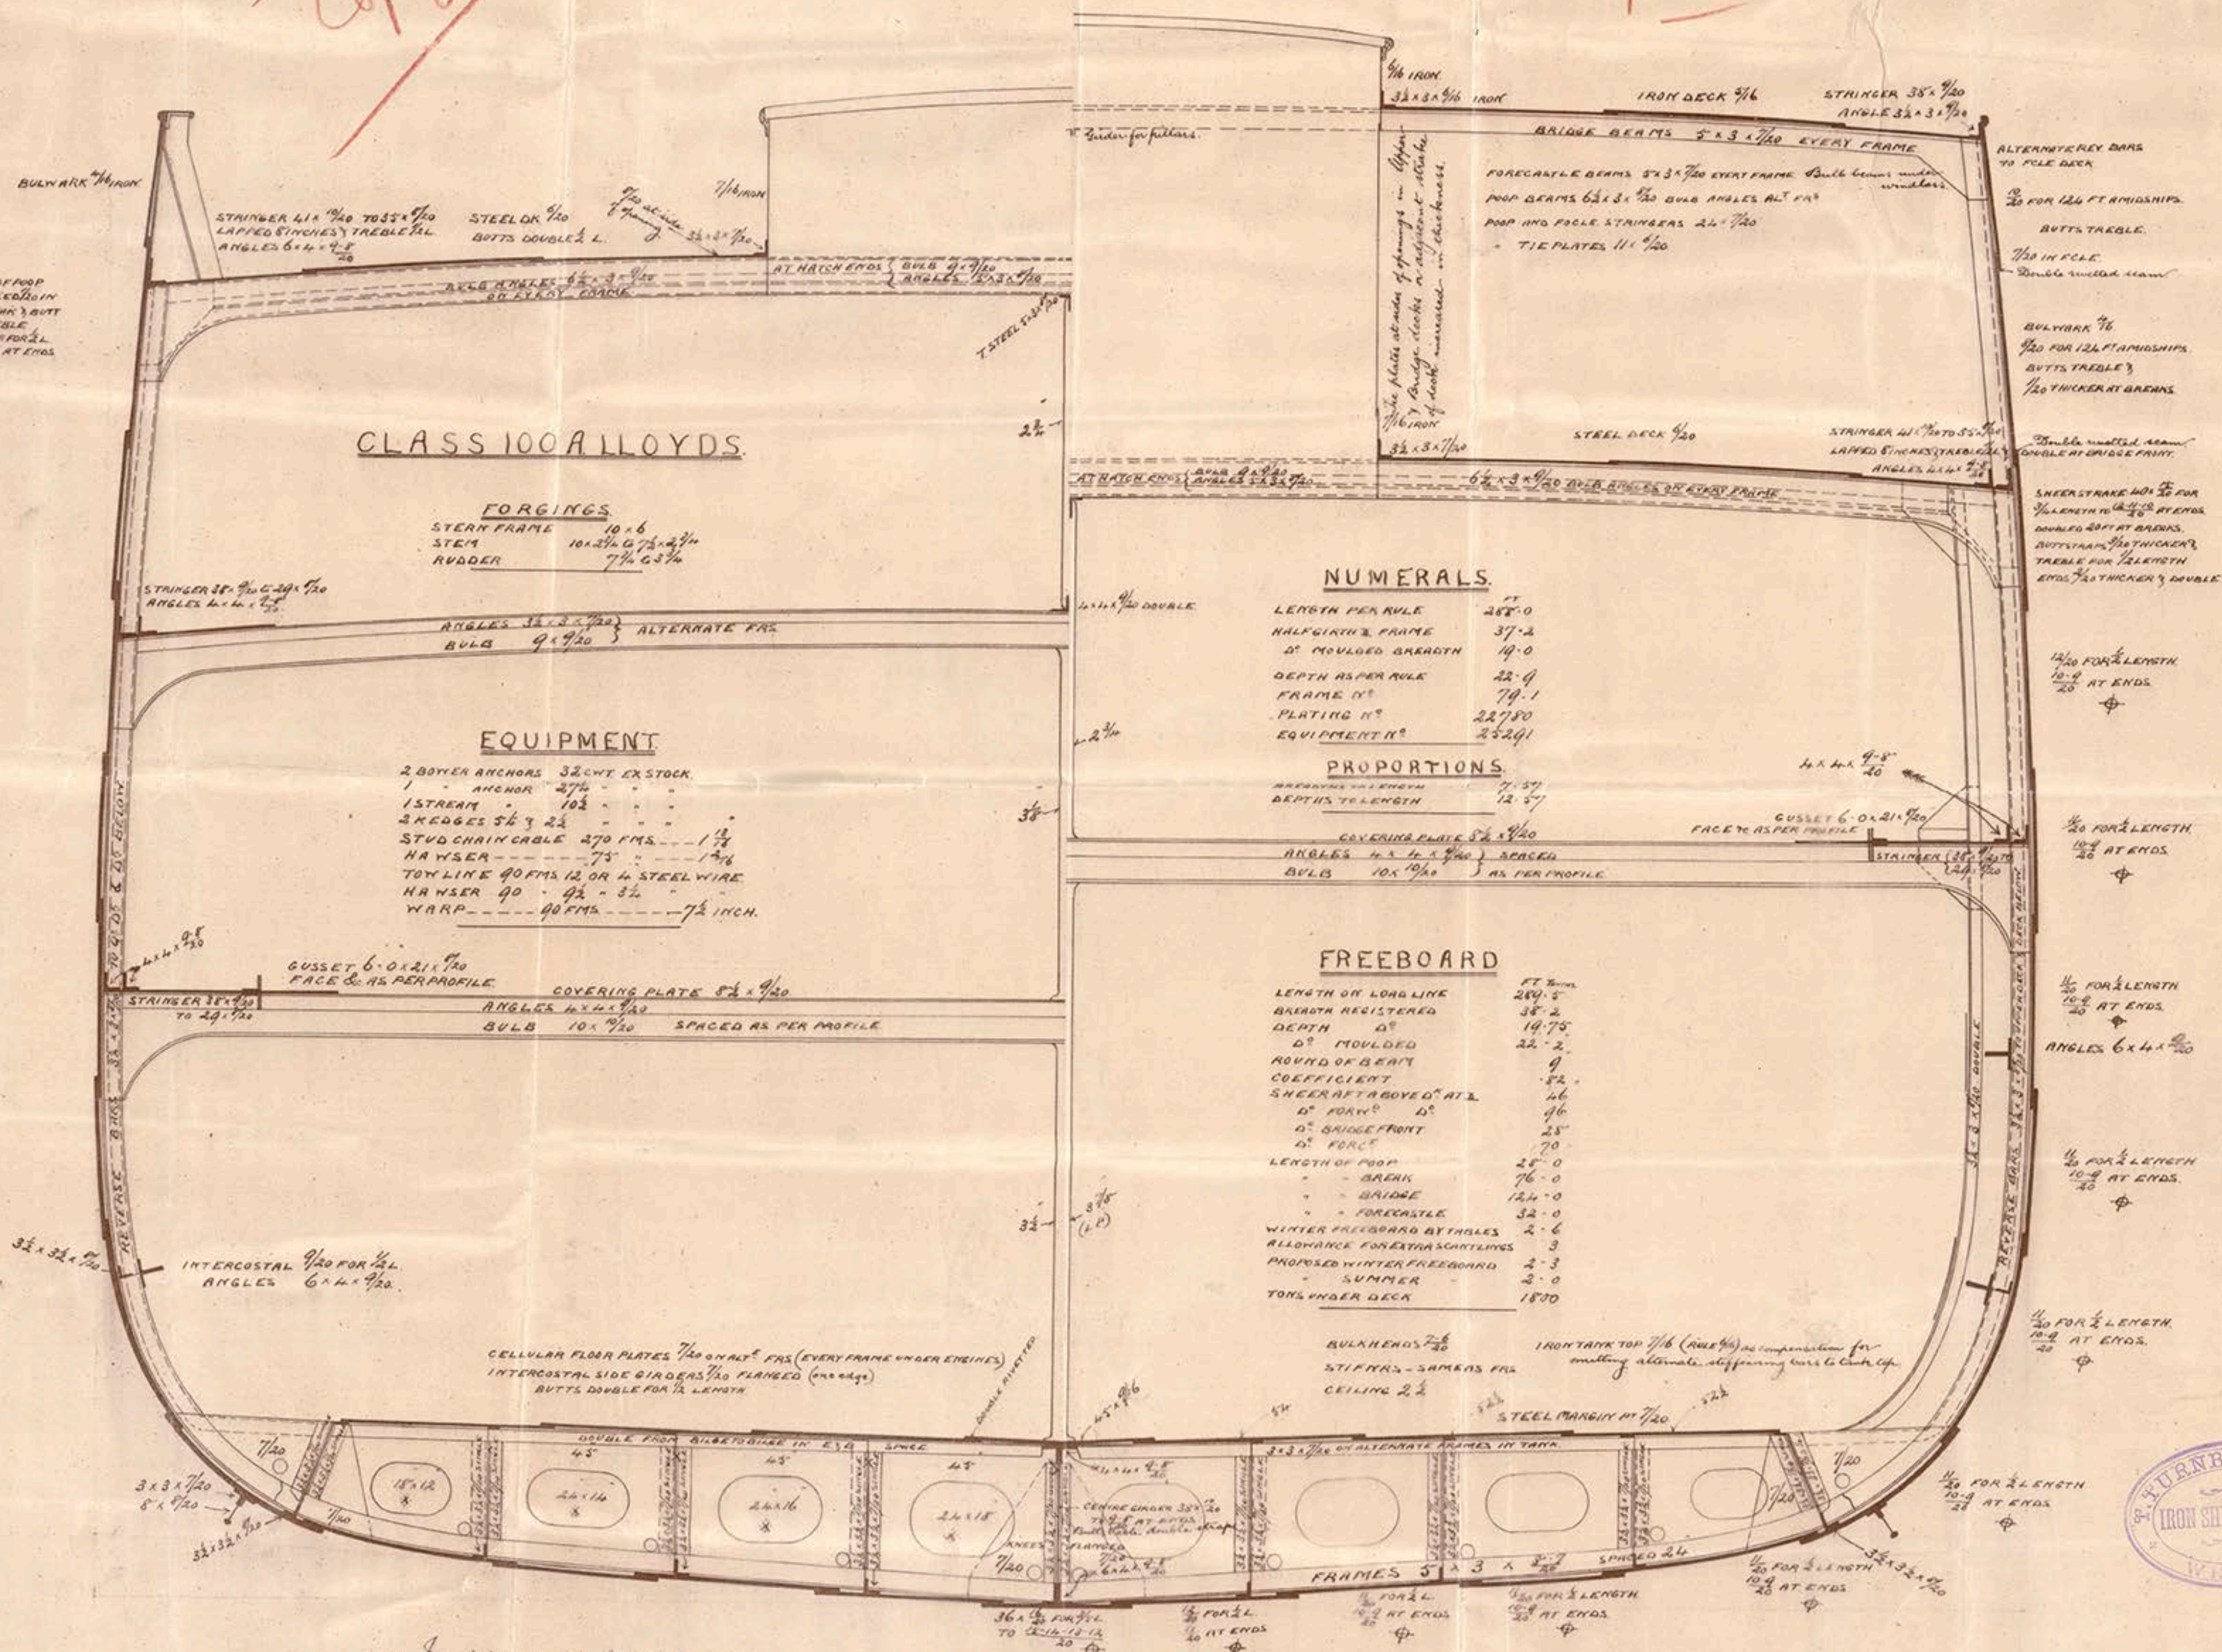

* Holes not to be larger nor more numerous than necessary to render all parts easily accessible.

⊕ SHELL BUTT STRAPS $\frac{3}{20}$ THICKER $\frac{3}{4}$ TREBLE FOR $\frac{1}{2}$ LENGTH
" $\frac{7}{40}$ " " DOUBLE RT EYES.

OUTSIDE PLATING ABOVE 40 INCHES BUT NOT EXCEEDING 46 IN WIDTH
INSIDE " OF 48 " " " 54 " "
BUTTS TO BE TREBLE RIVETED $\frac{1}{4}$ " THICKER IN
ADDITION TO REQUIREMENTS IN CIRCULAR 532

HPL 362/131

T. Turnbull & Co
Whitby

No 115 Vessel

Sketch of Midship
Section

S. S. "Nethergate"

N. S. Report No. 8050



© 2018

Lloyd's Register
Foundation