

# MIDSHIP SECTION

S.S. 397

S.S. Ipsden

## EQUIPMENT

2 BOWER ANCHORS EX STOCK 27 3/4 CWTs  
1 STREAM 8 3/4  
1 KEDGE 4 1/2  
1 2 1/4  
270 FATHOMS OF 1 1/4" STUD CHAINCABLE  
75 1 1/4" STREAM  
90 11" TOWLINE (OR 3 1/2" STEEL WIRE)  
90 9" WARP  
90 7"

	BUILDERS	LLOYDS
LENGTH B.P.	260.0	258.42
BREADTH EXTREME	36.6	36.33
DEPTH OF HOLD	18.2 1/2	20.08
MOULDED	19.5	1/2 BREADTH 18.16
Nº FOR FRAMES	72.24	1/2 GIRTH 34.00
PLATING	18668.26	DEPTH 20.08
EQUIPMENT Nº	20787.24	72.24
DEPTH TO LENGTH	12.86	
BREADTHS TO	7.11	


## EQUIPMENT Nº

LENGTH OF ERECTIONS = 234.42  
VESSEL 258.42 \* 1/2 = 5.81  
18668.26  
5.81 = 2118.98 + 18668.26 = 20787.24

TO CLASS 100 A.1 AT LLOYDS

SCALE 1/2 INCH TO ONE FOOT

SCANTLINGS OF STEEL IN 1/20  
IRON 1/16

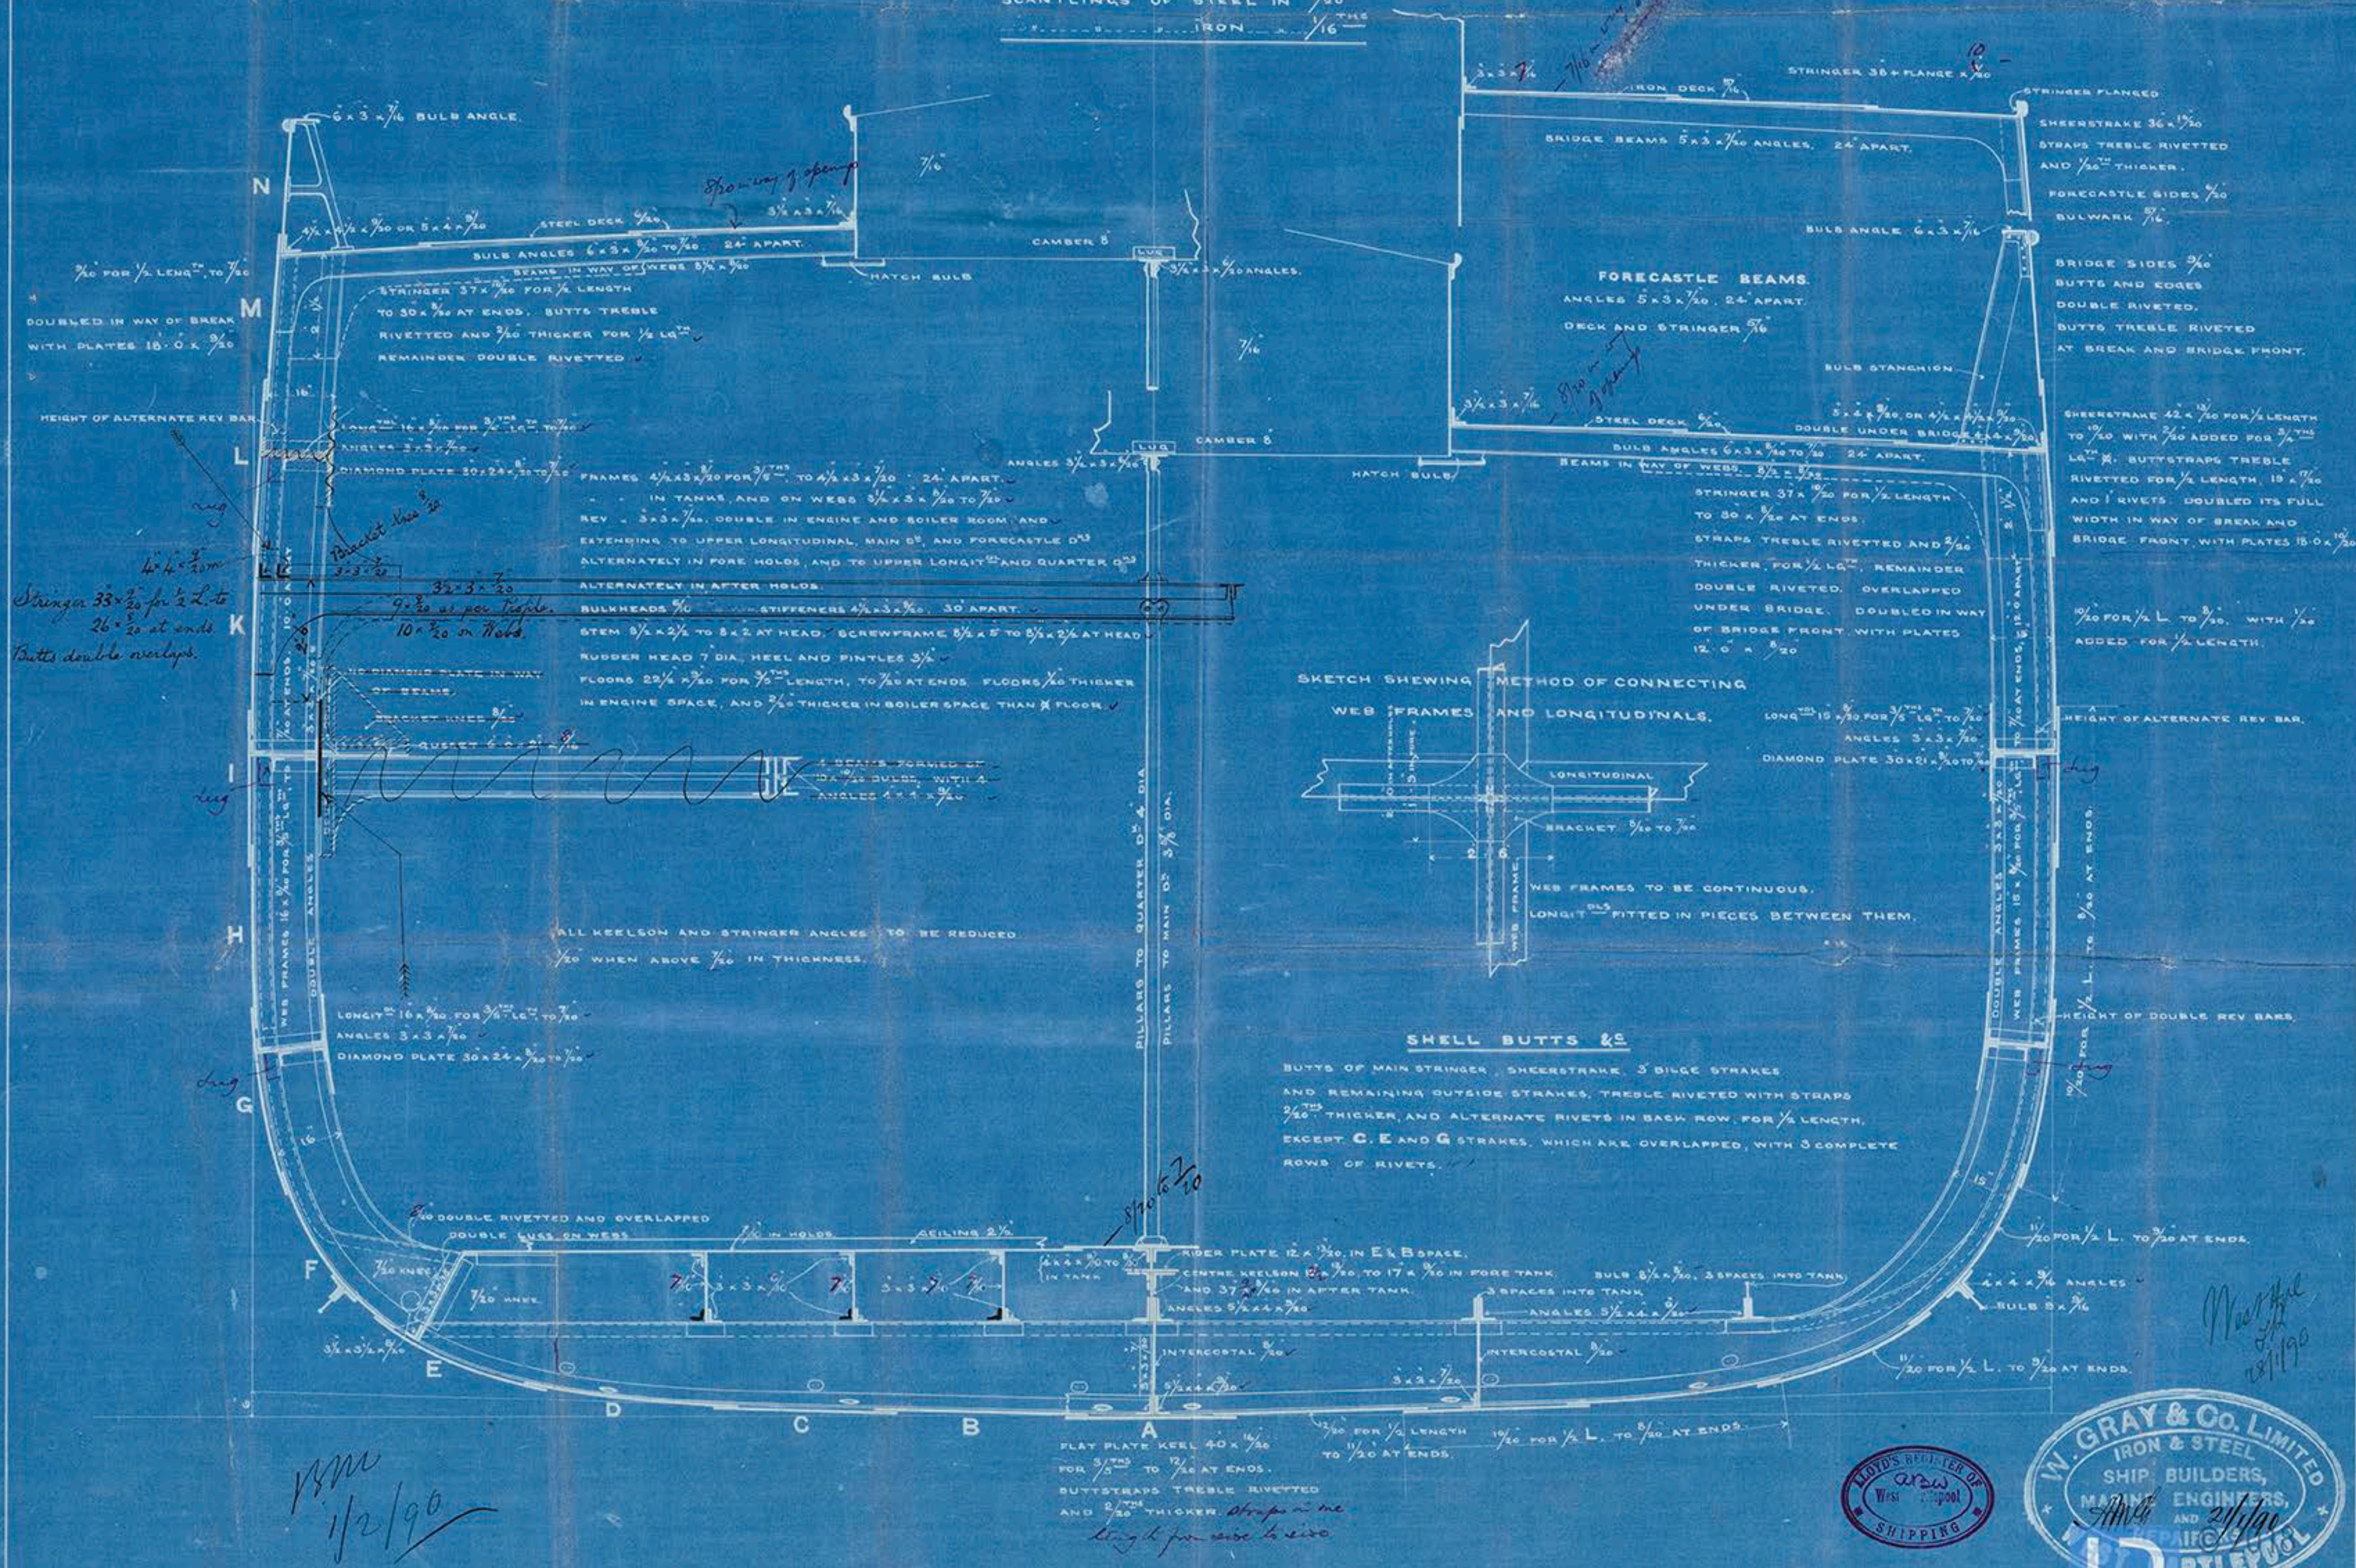



Messrs W. Gray & Co  
S.S. N<sup>o</sup> 394 + 96  
S.S. Ipsden.

Same as N<sup>o</sup> 396 + 8.

Sept. 8234

