


HP 363/117 2/2

7
E
FOOT.

S.S. "Ipodon"

SCANTLING OF STEEL IN $\frac{1}{20}$ " THS
-----IRON----- $\frac{1}{16}$ " THS

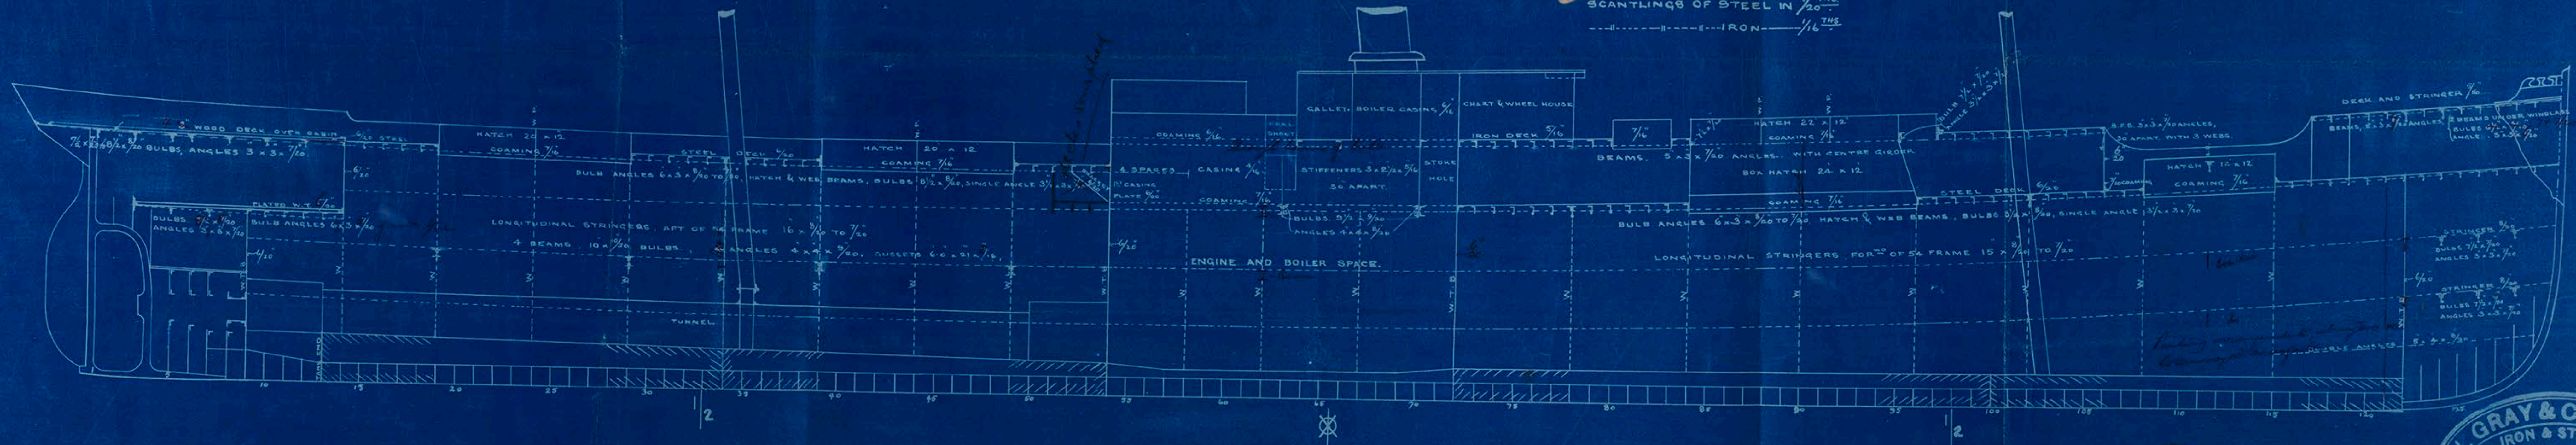

W. GRAY & Co. LIMITED
IRON & STEEL
SHIP BUILDERS,
MARINE ENGINEERS,
AND REPAIRERS
HARTLEPOOL

LR Lloyd's Register
Foundation


BEAMS MARKED A, BULBS $9 \times \frac{9}{20}$, ANGLES $3\frac{1}{2} \times 3 \times \frac{7}{20}$
 " B " $10 \times \frac{10}{20}$ " $4 \times 4 \times \frac{9}{20}$
 " TO HAVE COVERING PLATE $8\frac{1}{2} \times \frac{9}{20}$
 " GUSSETS $6 \times 30 \times \frac{9}{20}$

S.S. N^os 396-7 & 8

SCALE $\frac{1}{8}$ INCH = 1 FOOT.

MON 24 FEB 90
 FRI 28 FEB 90

*Through beams in way
 of webs 10"*

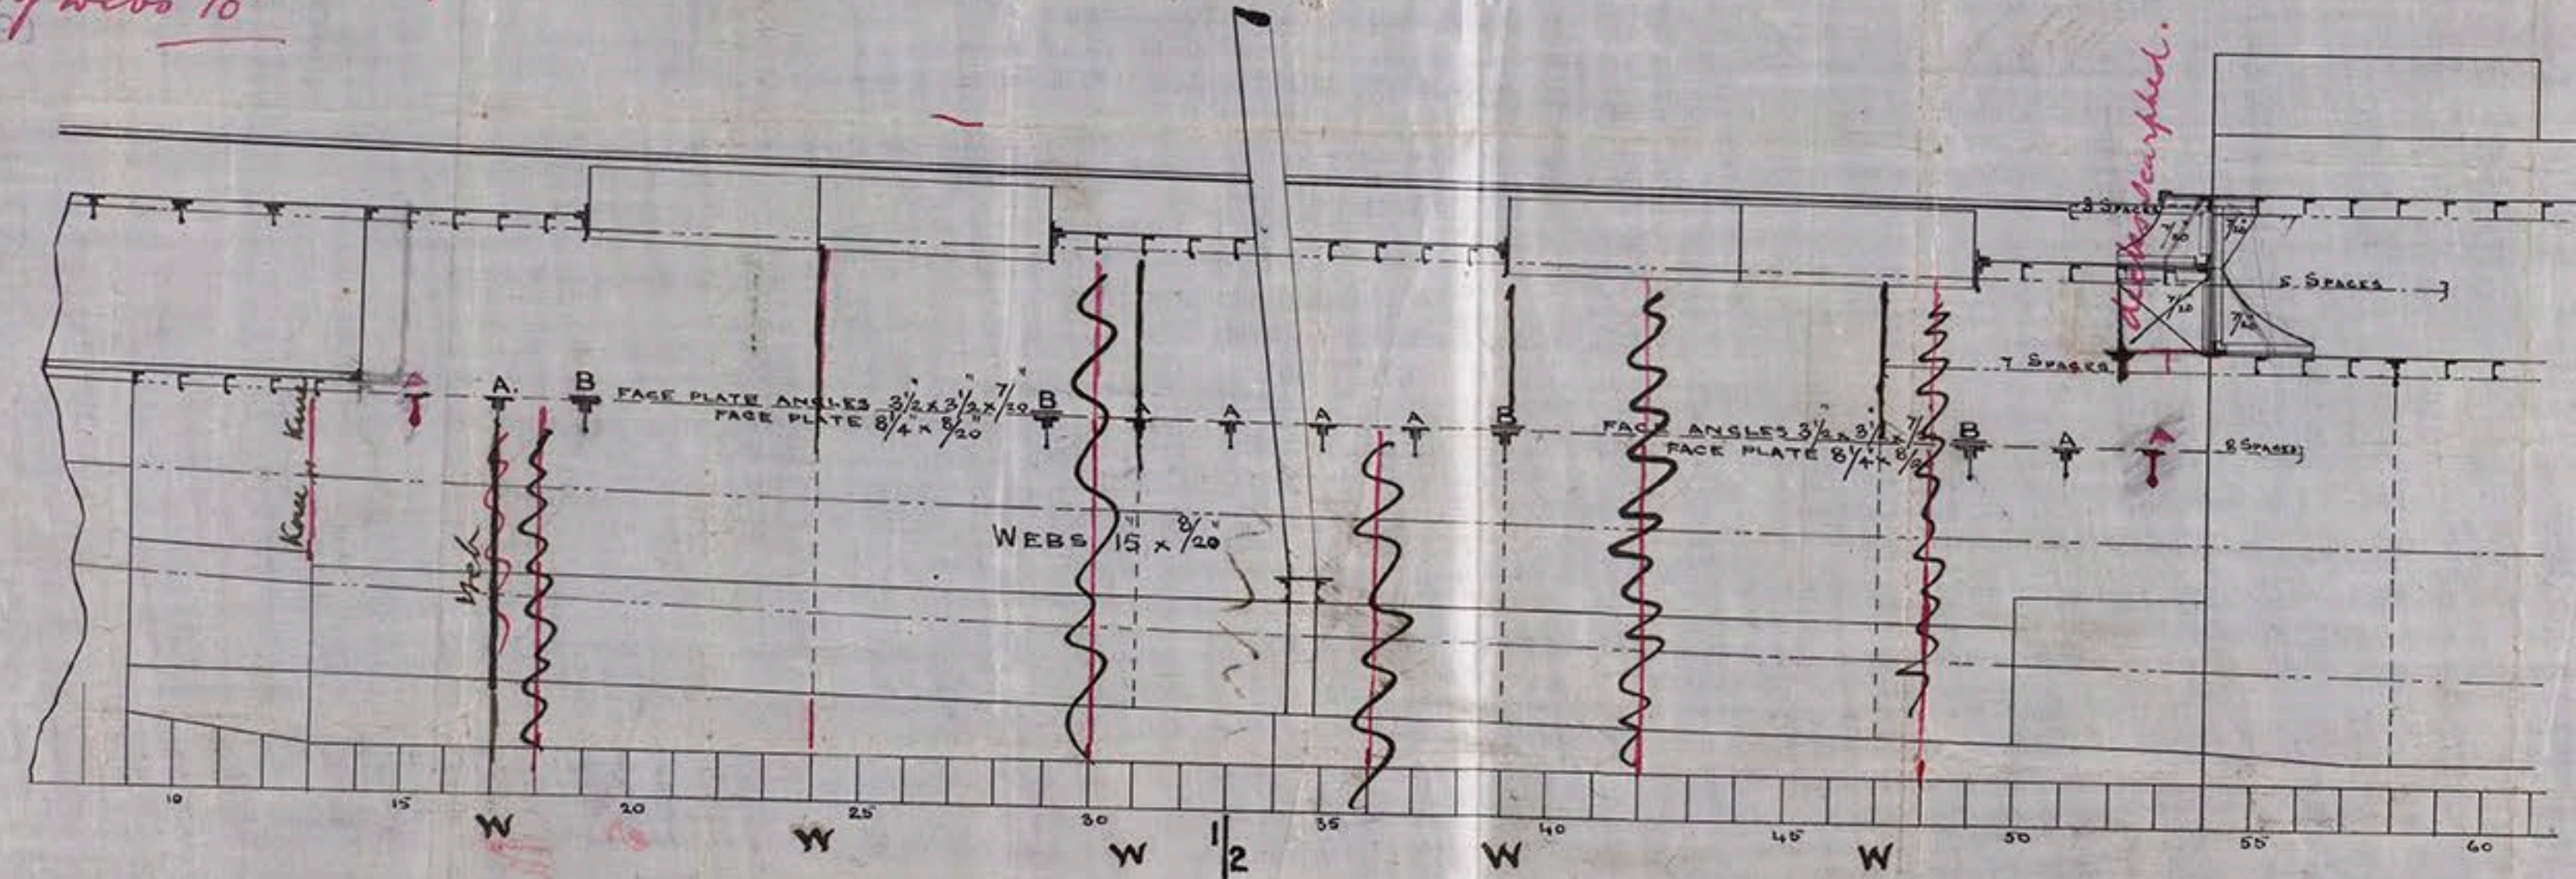

*W. Gray
 20/2/90*

FOOT.

S.S. "Ipsdon"

SCANTLING OF STEEL IN $\frac{1}{20}$ THS
 ---IRON--- $\frac{1}{16}$ THS

