


Zanzibar

THU 14 JUL 90  
TUE 26 AUG 90  
19/2/91.

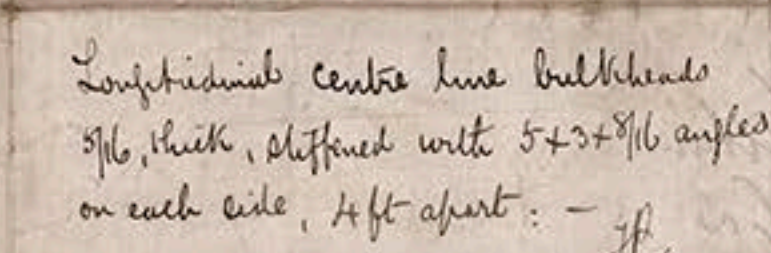

CLASS 100A1.

ALL SCANTLINGS OF STEEL EXCEPT WHERE OTHERWISE SPECIFIED.

BEAM BULB ANGLE ON EVERY FRAME  $7\frac{1}{2} \times 3 \times 9\frac{1}{20}$  ✓  
BEAM BULB AT WEB FRAMES & HATCH ENDS  $9\frac{1}{2} \times 9\frac{1}{20}$  ✓  
BEAM DOUBLE ANGLES  $3\frac{1}{2} \times 3\frac{1}{2} \times 7\frac{1}{20}$  ✓  
STRINGER PLATE  $4\frac{1}{2} \times 10\frac{1}{20}$  TO  $37 \times 9\frac{1}{20}$  +  
STRINGER ANGLES  $4\frac{1}{2} \times 4\frac{1}{2} \times 9\frac{1}{20}$  ✓  
IRON DECK  $7\frac{1}{16}$  in Steel 7 in

BEAM ANGLES  $5\frac{1}{2} \times 3 \times 7\frac{1}{2}$  10' 1"  
IRON DECK  $5\frac{1}{16}$  Stringer  $7\frac{1}{16}$

BEAM BULB ANGLES ON ALTERNATE FRAMES  $7 \times 3 \times \frac{8}{20}$   
STRINGER PLATE  $24 \times \frac{7}{20}$

BEAMS IN HOLDS — PLATE  $11 \times \frac{11}{20}$  4 ANGLES  $5 \times 4 \times \frac{9}{20}$   
STRINGER PLATE  $41 \times \frac{9}{20}$  TO  $32 \times \frac{8}{20}$   
STRINGER ANGLES  $4 \times 4 \times \frac{9}{20}$  —  
INNER ANGLES  $4 \times 3 \frac{1}{2} \times \frac{7}{20}$  FACE PLATE  $8 \frac{1}{2} \times 8 \times \frac{7}{20}$

© 2018  
Lloyd's Register  
Foundation



TST/8967dH

N<sup>o</sup> 178, 179, 180 & 181

No 178. S. S. Zanzibar  
Hb. pl. 5290

No. 179 - S. S. Wildcroft  
i. h. l. 8251

180  
Calcutta City  
Kpl. 8402

See Separate M.S. + Photo

181. Cackleventry S/S

Appl. 8443  
See N.S. Separatim app. - H. p. 10

51-32 *with Calcutt*