

Irvine H^{rs}

no 72. S.S.

S.S. "Silvia"

Hpl 8517

HPL 365 - 0062



© 2019

Lloyd's Register
Foundation

PARTICULARS FOR FREEBOARD.

ERECTATIONS.	HEIGHT	SHEER
POOP =	20.10	7.0
R.Q.DS =	61.4	3.9
BRIDGE =	95.10	6.9
WELL =	17.3	
T.G. CASTLE =	29.0	6.9

SHEER	HEIGHT
SHEER AFT. =	2.3
AT POOP FRONT	1.3
AT END OF BRIDGE	0.7
AT FORE END BRIDGE	2.1
AT END OF CASTLE	3.3
AT END OF STEM	6.0

DEPTH FROM TOP OF KEEL TO TOP OF MAIN DECK STRINGER PLATE = 16.14

AT AN ASSUMED WATERWAY OF 16 INCHES

DEPTH FROM TANK TOP TO TOP OF MAIN DECK BEAM AT CENTRE = 13.52

TONNAGE UNDER MAIN DECK = 865 TONS.


PROFILE S.S. NO 72

S. S. Silvini

SCALE 1/8" = ONE FOOT

DIMENSIONS.
LENGTH D.P. 231.6
BREADTH EX. 32.6
DEPTH (MOULDED) 16.0.

CELLULAR BOTTOM

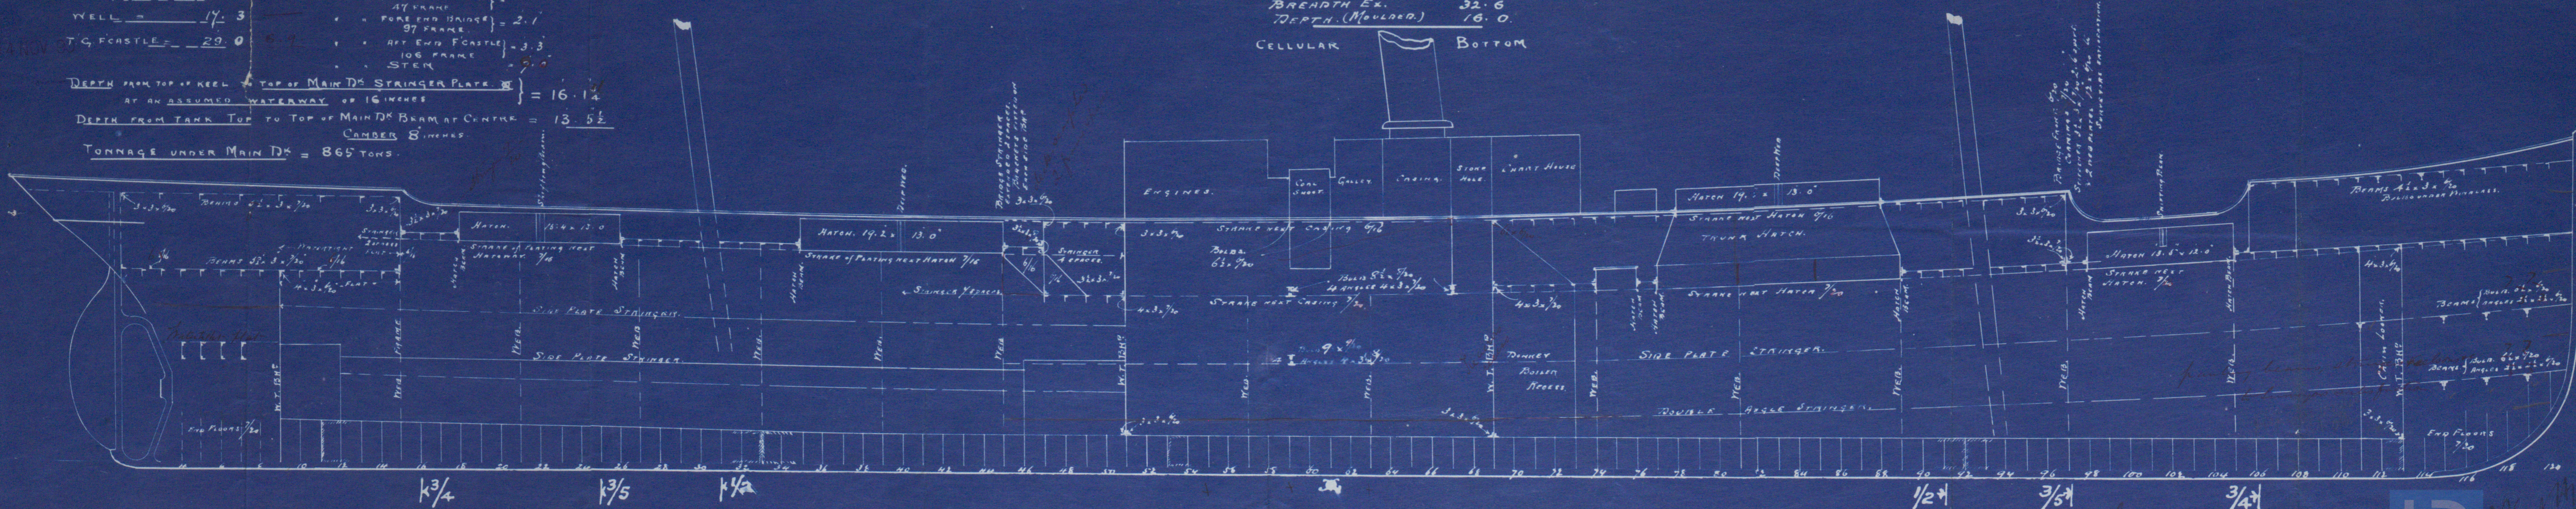

11/1/90

West Hill
J.P.
25/10/90