




no 72

S. S. Silvia

71678377

APL 365-0056


© 2019

Lloyd's Register
Foundation

IRON MASTS FOR MESSRS. IRVINE & CO'S S.S. N^o 72.

8.5.91.

FORE MAST.

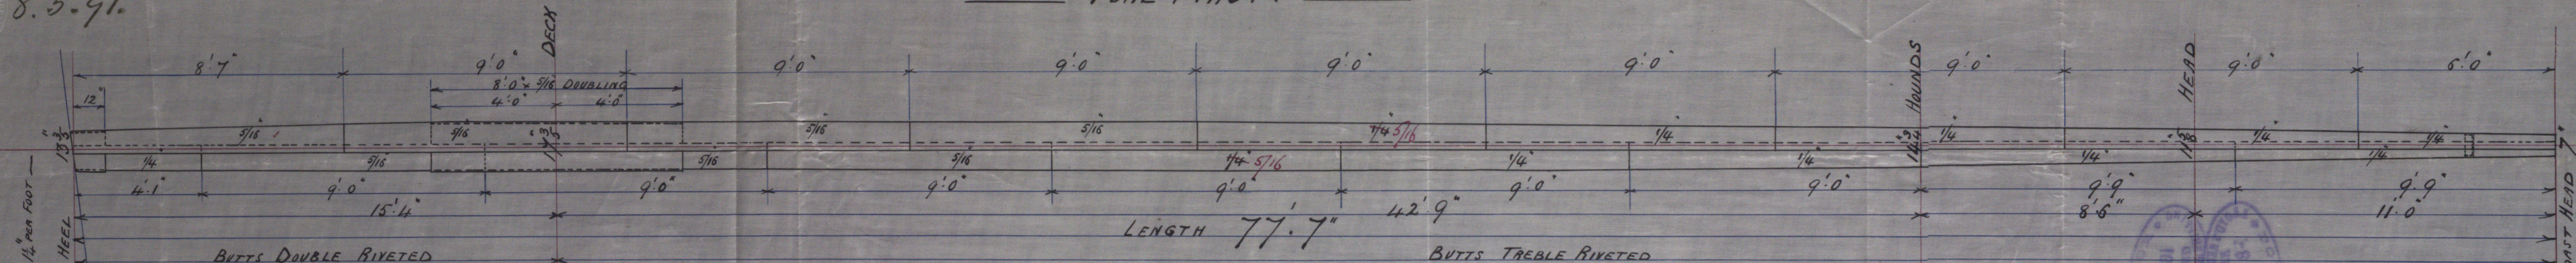

LONGITUDINAL SEAMS SINGLE RIVETED - RIVETS 3/4 DIA. 3" PITCH -

MAIN MAST.

