

15.7.91.

PLAN OF IRON LOWERMMASTS.

MESSRS EDWD WITHY & COS N^o 185. S.S


SCALE $\frac{1}{4}$ INCH TO A FOOT

Note! Masts to be made in two plates in the round, outside strake on fore side.


Butts & seams to be rivetted with $\frac{3}{4}$ rivets, 5 diameters apart, seams double rivetted throughout.

Buttstraps treble rivetted, except those in housings of masts

Foremast

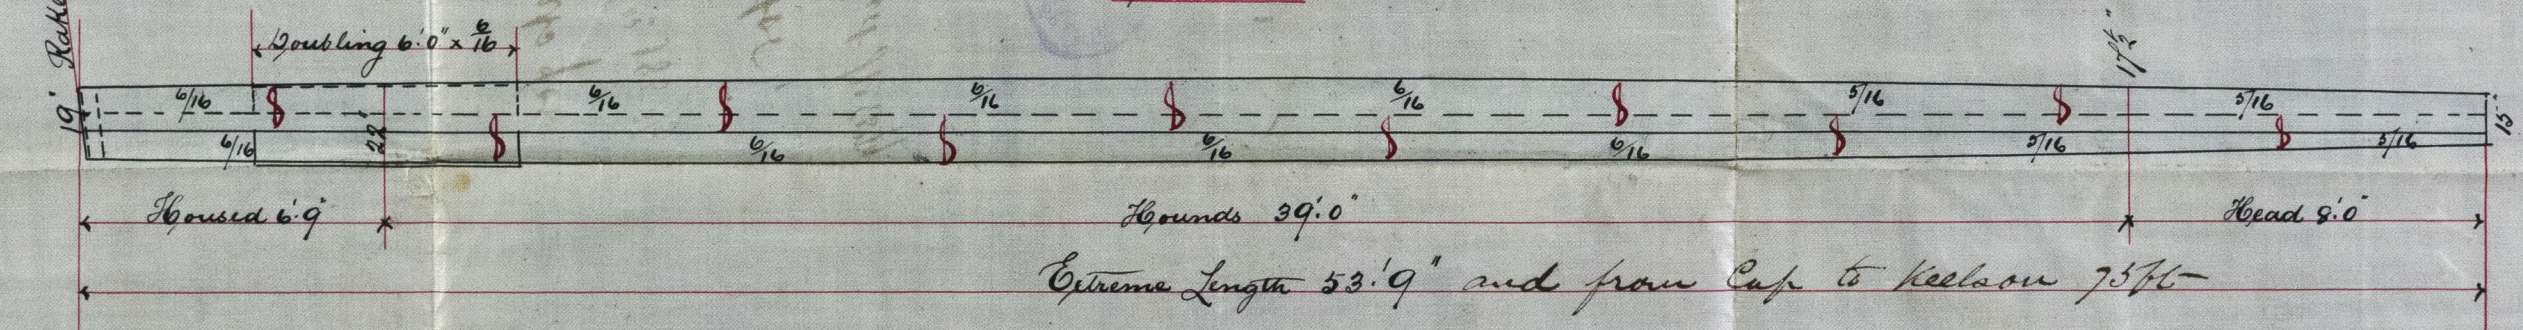

Mainmast

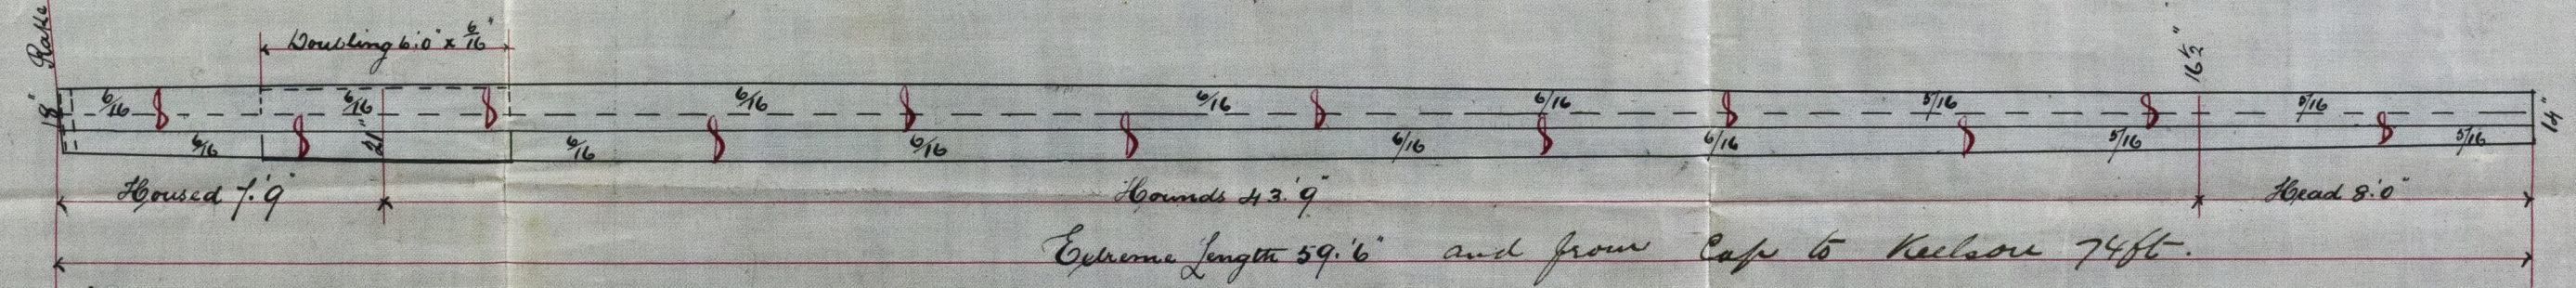

These masts have been built in accordance with the scantlings and arrangements shown herein.

Jesse Williams
14-7-91

THOMAS SUDRON & Co., Limited
IMPERIAL BOILER WORKS,
STOCKTON-ON-TEES

11 JUN 1891



HPL366-0018

HPL 366 - 0018

Plan of masts for

G. W. Kithy 16th 1855 1/2

J. S. Rowton;

W. H. P. Report 1857 1/2



© 2019

Lloyd's Register
Foundation