


7.3.91.
29.8.91.

PROFILE
Scale $\frac{1}{8} = 1 \text{ foot}$

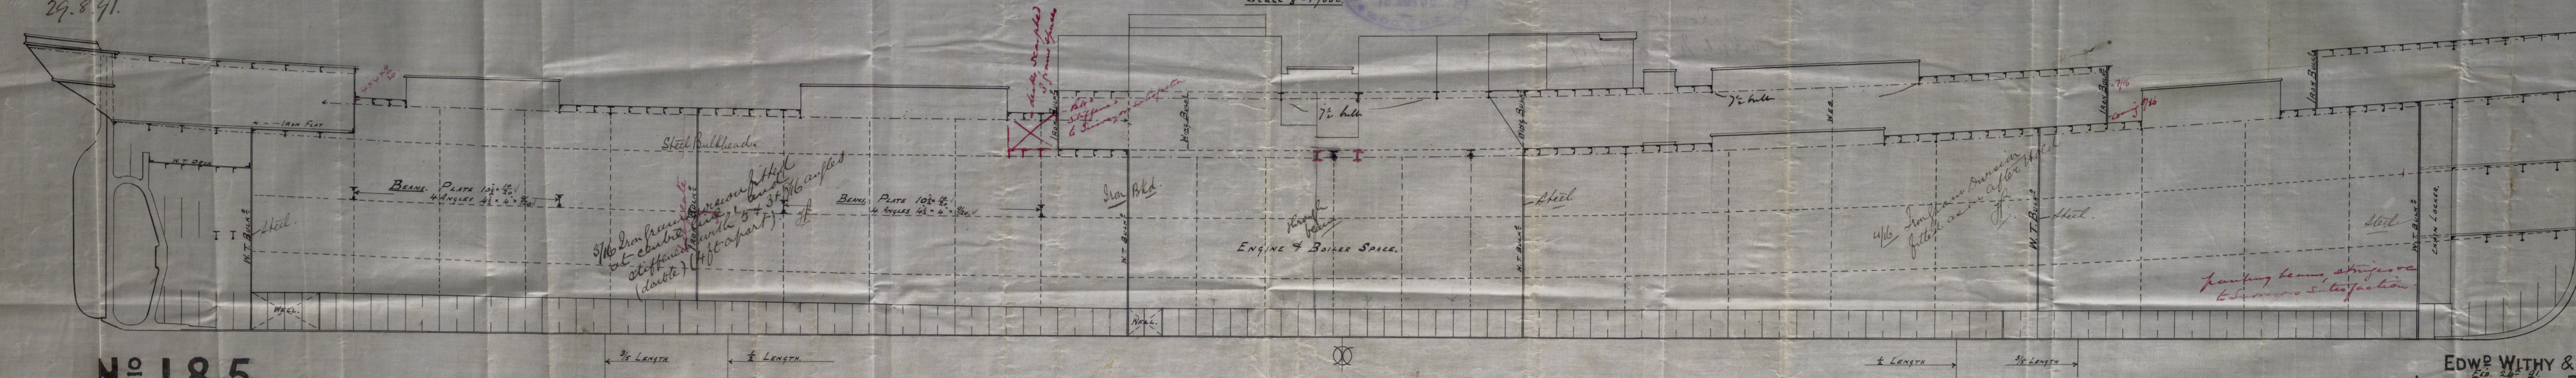

N^o 185.

4/16
7/3/91

EDWARD WITHEY & CO
IRON & STEEL SHIP BUILDERS
WEST HARTLEPOOL



HP 366-0019

© 2019
West of
Lloyd's Register
Foundation




HPL366-0019

Elevation

Messrs G. Withy & Co

No 185.
"Rowtor"


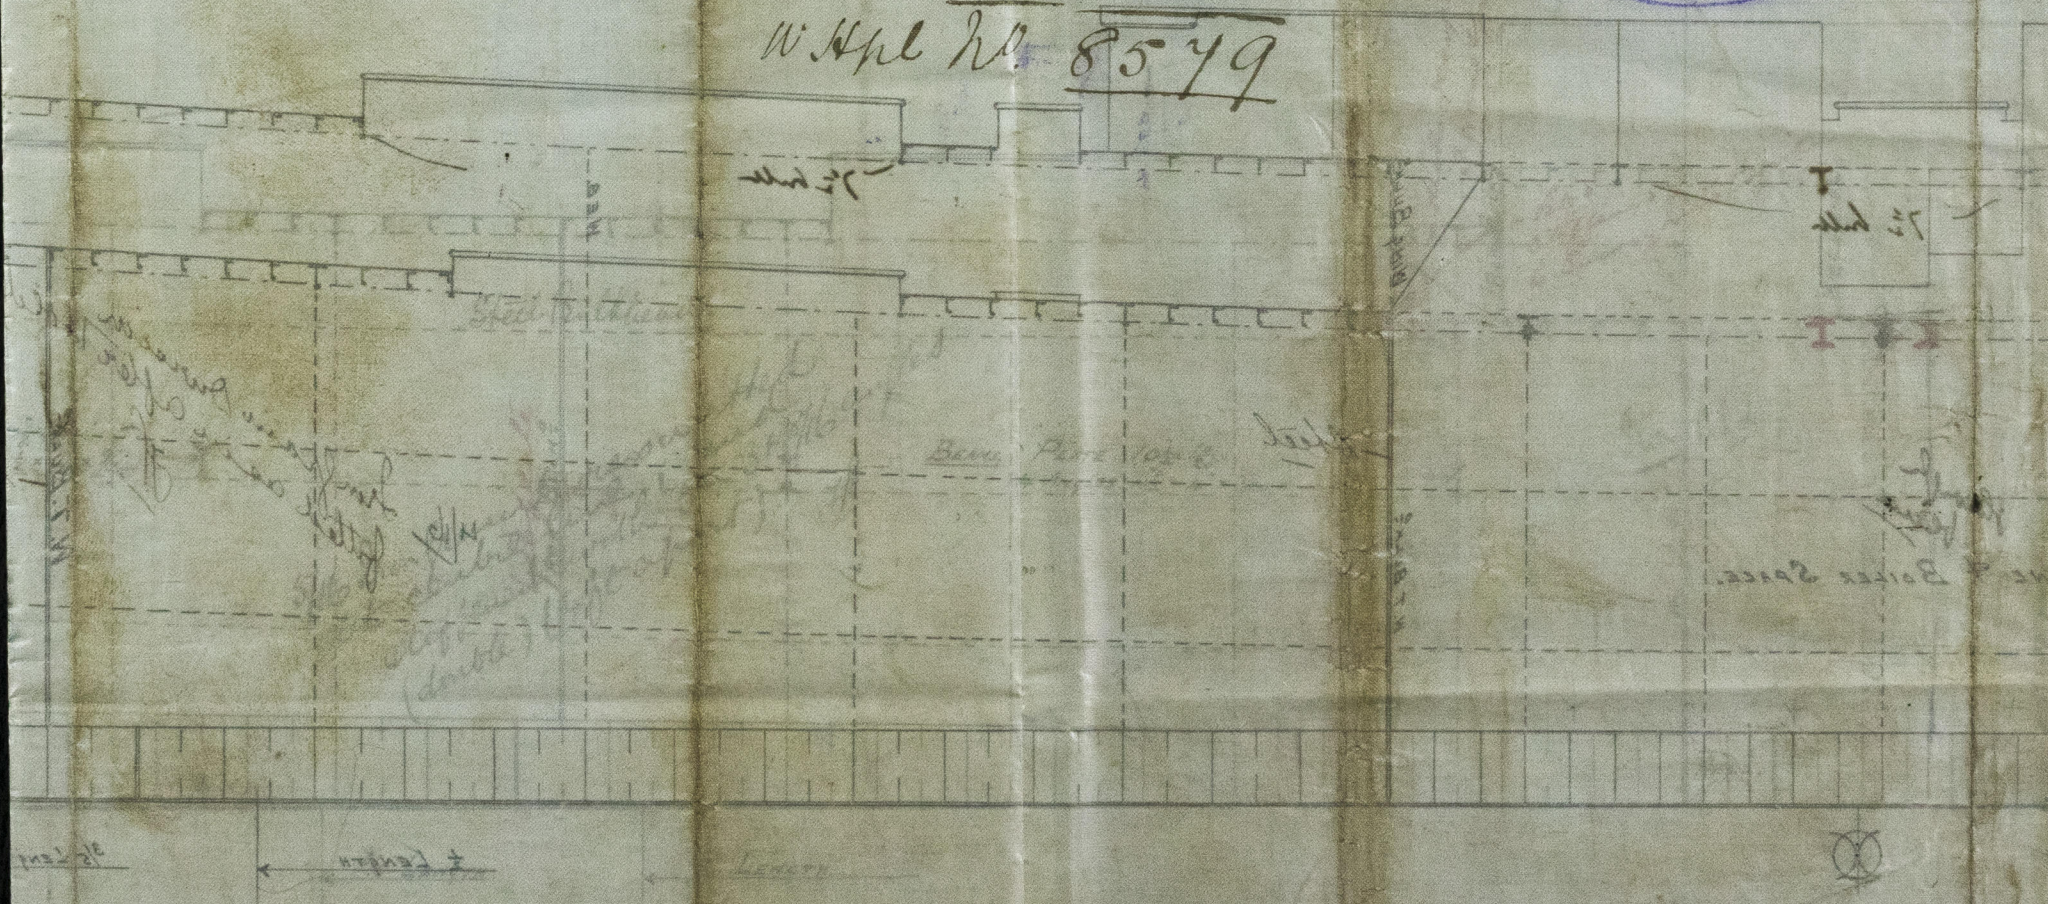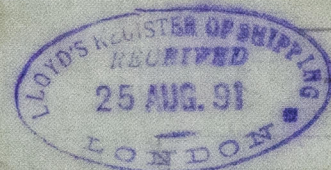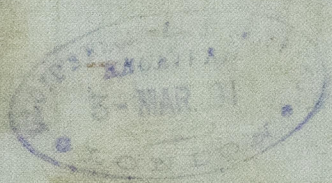

© 2019

Lloyd's Register
Foundation