


SCALE $\frac{3}{4}" = 1 \text{ FOOT.}$

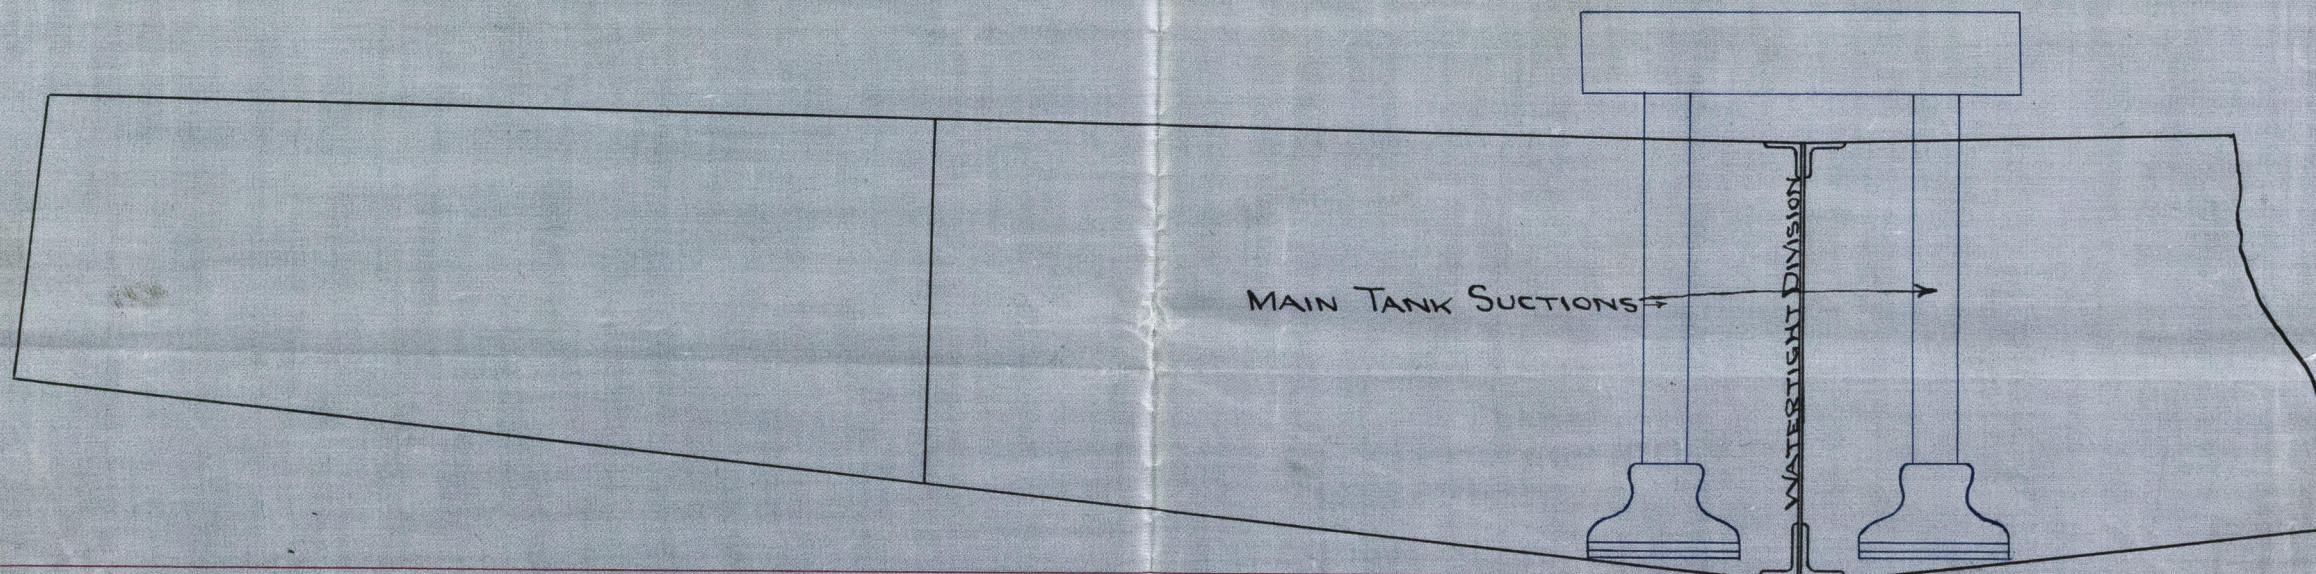

N^{os} ~~186~~ 187 & 188

EDWD. WITHY & Co.
SEPTEMBER 18TH 1891
IRON & STEEL SHIP BUILDERS

SHIP REPAIRERS & Co.

WEST HARTLEPOOL

Lloyd's Register
Foundation

HPL 366-0032