

The words FORGINGS or CASTINGS, IRON or STEEL, should be struck out as may be required.

J. J. "Emma"

Received at

WEST HARTLEPOOL.

Office,

27th July 1891

Lloyd's Register of British and Foreign Shipping.

(Report on Vessel No.

8607

Port

WEST HARTLEPOOL.)

Hartlepool

No. 1794 a

SHIP FORGINGS OR CASTINGS.

I have to report that the undermentioned Iron or Steel Forgings or Castings, manufactured by

The Darlington Forge Co.

of Darlington

for the Vessel No. 73, being built by Messrs Irvine & Co.

of Hartlepool

have been inspected by me as set forth below, and found

to be, so far as can be seen, sound

Mark on Forgings.

Lloyd's

No. 1794 a

16.6.


Wash Camm

Lindland

25/7/91

	STERN FRAME.	RUDDER FRAME.	STEM.
Material*	Scrap iron	Scrap iron	
How made	Forged	Forged	
Dimensions	11' x 5 1/2'	8' - 4"	
Progress on Inspection	Forged & Smithed	Forged & Smithed	Not seen
Dates when Inspected	Oct 3-11-22-30/90	Jan 2-12-23-30 July 3 10-16/91	

SKETCHES OF FRAMES SHEWING POSITION AND DESCRIPTION OF WELDS OF FORGINGS, OR PARTICULARS OF TESTS APPLIED TO CASTINGS.

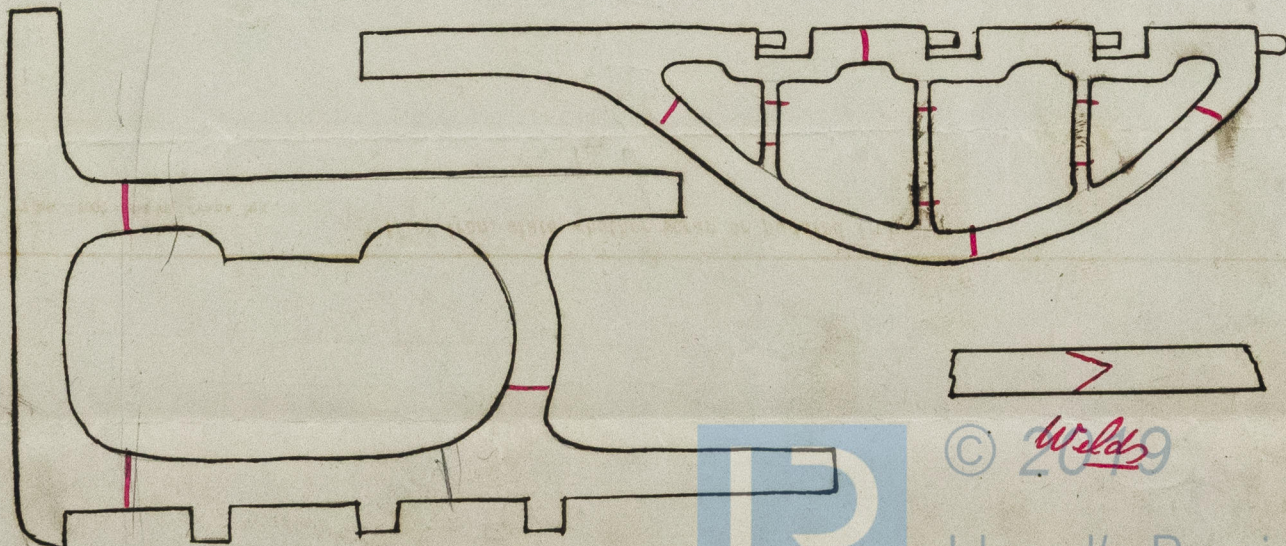

* If of Iron, state whether scrap or puddled Iron.