


23.7.91.


MESSRS. IRVINE & CO'S. S.S. No 73.

(STEEL)

Main Mast.

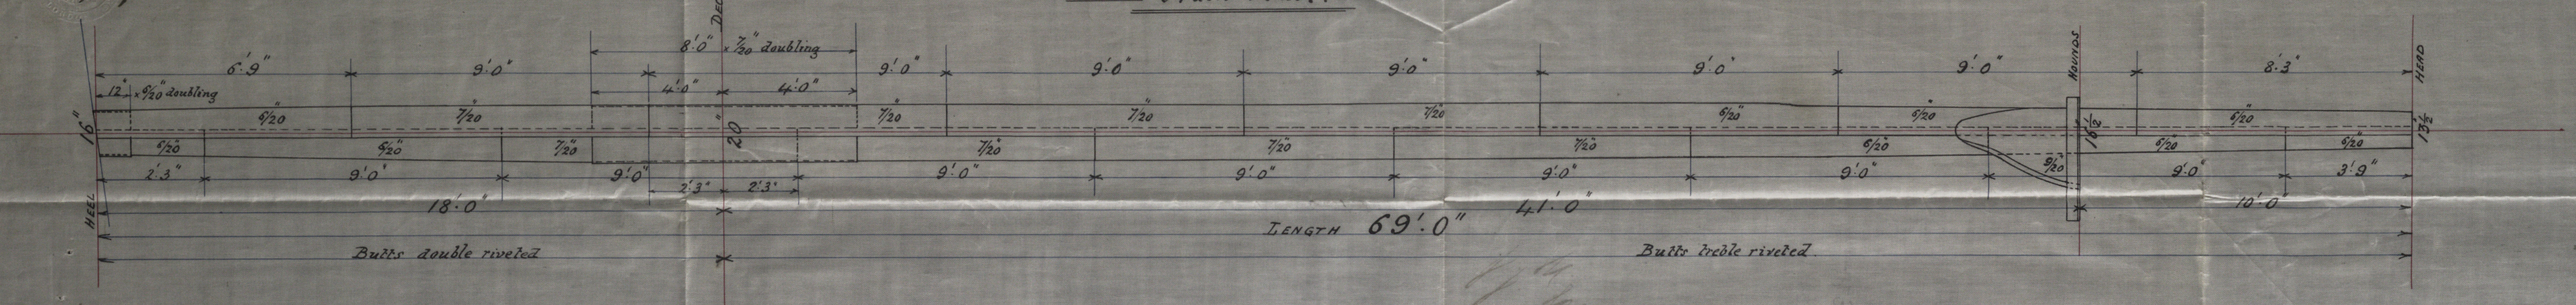


Fore Mast.

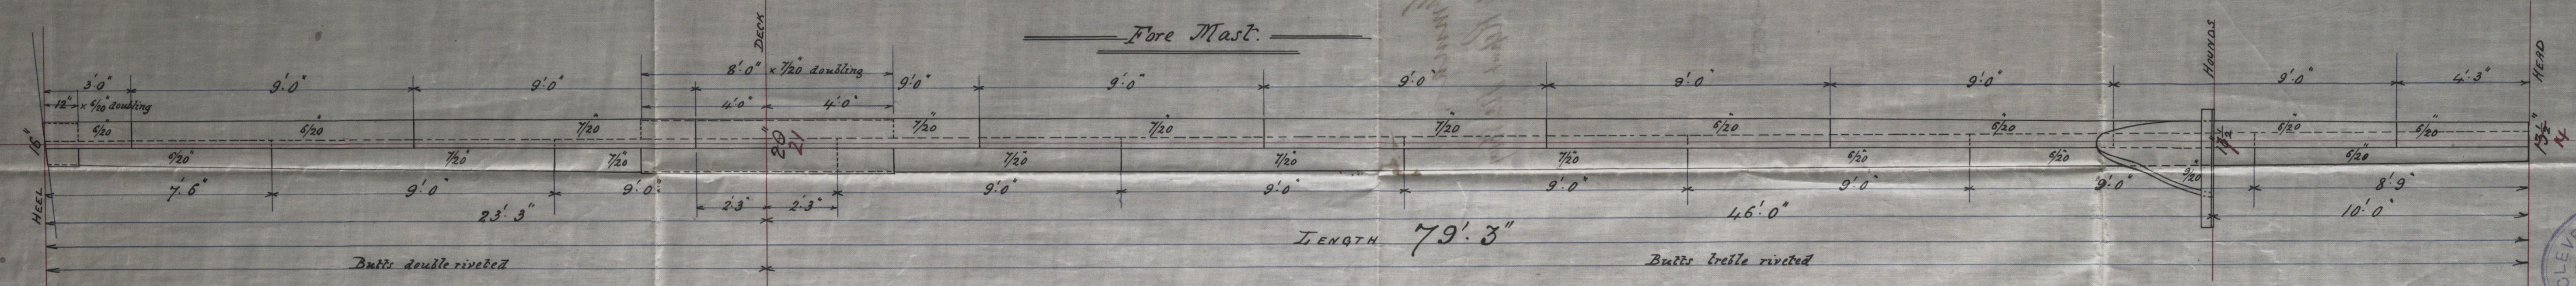

Note. Longitudinal Seams single riveted.
Rivets 3/4" dia. 3 3/4" pitch in double riveting.
Do. 3" pitch in single riveting.
Build straps 1/20" thicker than the plates they cover.

23/7/91

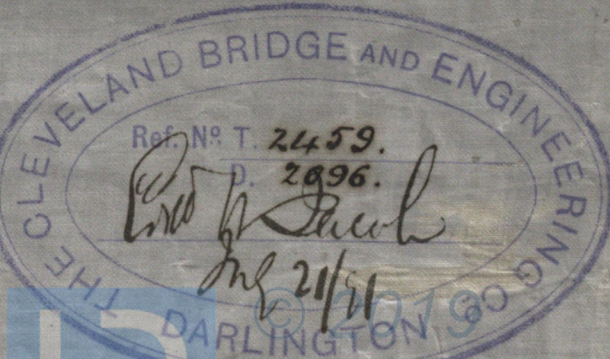

Lloyd's Register
HPL366-10051ndation

S.S. Emma

W. Hpl. Report No. 8607

British Empire

Fore Mast

HPL 366-0059

© 2010

Lloyd's Register
Foundation